
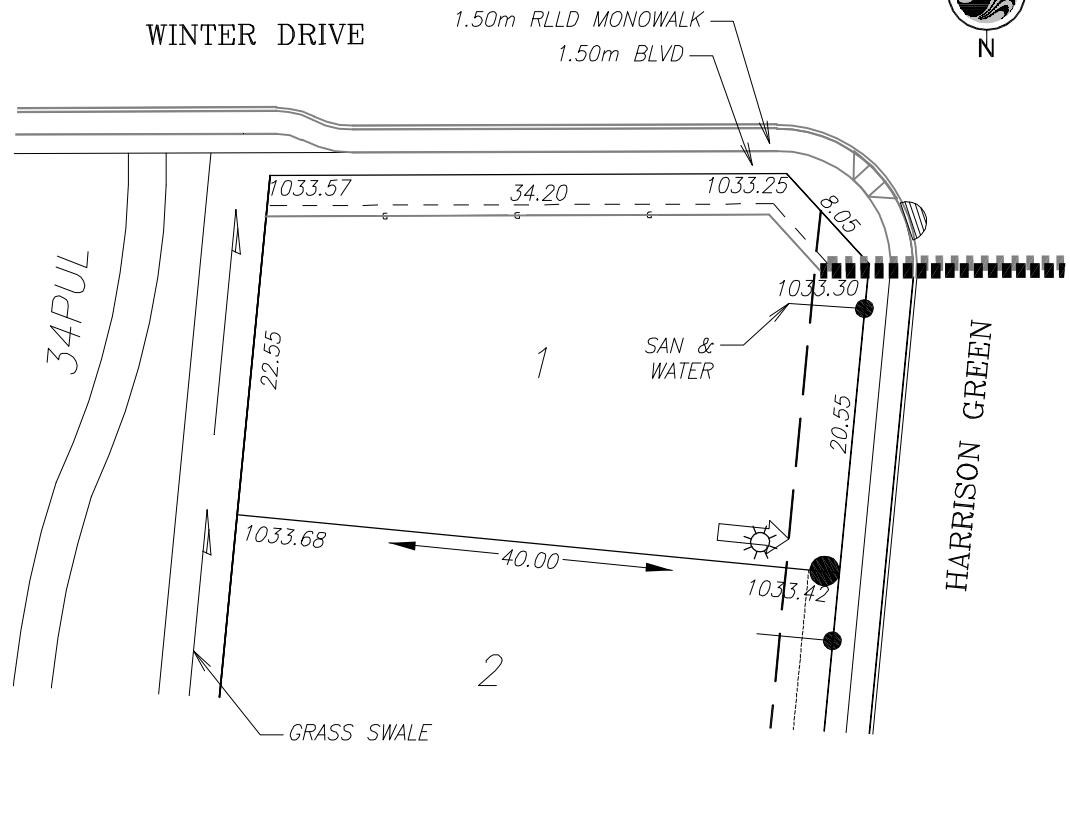


BUILDING GRADE CERTIFICATE

Town of Olds
Issued by: No.

1. WHEN EXCAVATING IN A RIGHT OF WAY (EASEMENT), CHECK FOR UTILITIES.
2. STANDING AT THE WATER SHUTOFF AND FACING THE BUILDING, THE SANITARY SERVICE (PAINTED RED) IS ON THE LEFT SIDE OF THE WATER SERVICE; STORM SERVICE (PAINTED GREEN) IS ON THE RIGHT SIDE OF THE WATER SERVICE.
3. ALL DIMENSIONS ARE IN METRES AND DECIMALS THERE OF. THE ELEVATIONS ARE IN METRES ABOVE GEODETIC MEAN SEA LEVEL.
4. ELEVATIONS NOTED ON THE CERTIFICATE ARE WITHIN 100mm OF ACTUAL.
5. THE BUILDER MUST CONSTRUCT WITHIN 100mm OF THE DESIGN LANDSCAPE ELEVATION & ILLUSTRATED DRAINAGE PATTERNS UNLESS OTHERWISE APPROVED BY THE DEVELOPMENT OFFICER.
6. IF THE INFORMATION ON THIS CERTIFICATE HAS BEEN PREPARED BY A PRIVATE DEVELOPER OR THEIR AGENT, THE TOWN OF OLDS ACCEPTS NO RESPONSIBILITY FOR ITS ACCURACY.

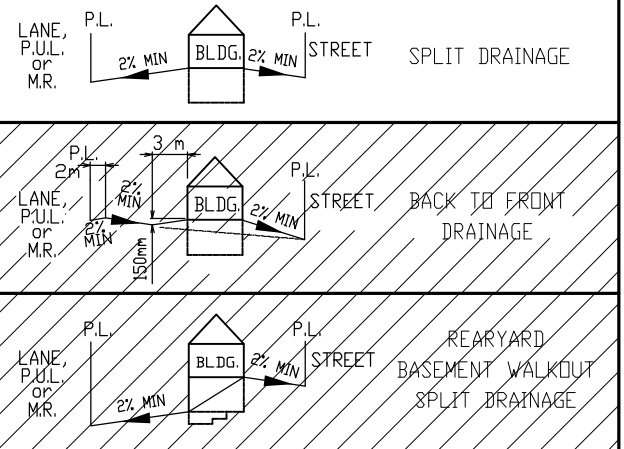

LEGEND

- SAN, WATER & STORM
- ⊙ FIRE HYDRANT
- - - GAS
- ⚡ POWER, TELEPHONE & CABLE SERVICE
- ⦿ STREET LIGHT
- ⊠ COMMUNITY MAILBOX
- TRANSFORMER
- EL&P TRANSFORMER
- SHAW PEDESTAL
- ▲ TELEPHONE PEDESTAL
- 3 PARTY PEDESTAL

POWER SERVICE LOCATION IS 4.5m FROM SIDEYARD LOTLINE
WATER & SANITARY LOCATION IS 4.5m FROM SIDEYARD LOTLINE.

TOP OF FOOTING:
MAX. DEPTH BELOW AVERAGE SIDEWALK = 2.27
LOWEST ELEVATION = 1031.05

AS-BUILT SEWER INVERT ELEVATIONS:
SANITARY AT 4.0m INSIDE LOT = 1030.20
STORM AT 4.0m INSIDE LOT = N/A

CIVIC ADDRESS: 2 HARRISON GREEN
LOT: 1 BLOCK: 1 PLAN No.:
DEVELOPER: RICHARDSONS BROTHERS SCALE: 1:500
DRAWN BY: STANTEC CONSULTING LTD DATE: NOV 18, 2013
APPROVED BY: BARRY MASON DATE: NOV 18, 2013
RECEIVED BY: DATE:



DESIGN LANDSCAPE ELEVATIONS
ELEV. AT FRONT OF HOUSE = 1033.72
ELEV. AT REAR OF HOUSE = 1033.98

I CERTIFY THAT THE FINAL LANDSCAPE GRADE WILL BE (FRONT) _____
(REAR) _____
SIGNATURE OF OWNER OR REPRESENTATIVE _____

BUILDING GRADE CERTIFICATE

Town of Olds
Issued by: No.

1. WHEN EXCAVATING IN A RIGHT OF WAY (EASEMENT), CHECK FOR UTILITIES.
2. STANDING AT THE WATER SHUTOFF AND FACING THE BUILDING, THE SANITARY SERVICE (PAINTED RED) IS ON THE LEFT SIDE OF THE WATER SERVICE; STORM SERVICE (PAINTED GREEN) IS ON THE RIGHT SIDE OF THE WATER SERVICE.
3. ALL DIMENSIONS ARE IN METRES AND DECIMALS THERE OF. THE ELEVATIONS ARE IN METRES ABOVE GEODETIC MEAN SEA LEVEL.
4. ELEVATIONS NOTED ON THE CERTIFICATE ARE WITHIN 100mm OF ACTUAL.
5. THE BUILDER MUST CONSTRUCT WITHIN 100mm OF THE DESIGN LANDSCAPE ELEVATION & ILLUSTRATED DRAINAGE PATTERNS UNLESS OTHERWISE APPROVED BY THE DEVELOPMENT OFFICER.
6. IF THE INFORMATION ON THIS CERTIFICATE HAS BEEN PREPARED BY A PRIVATE DEVELOPER OR THEIR AGENT, THE TOWN OF OLDS ACCEPTS NO RESPONSIBILITY FOR ITS ACCURACY.

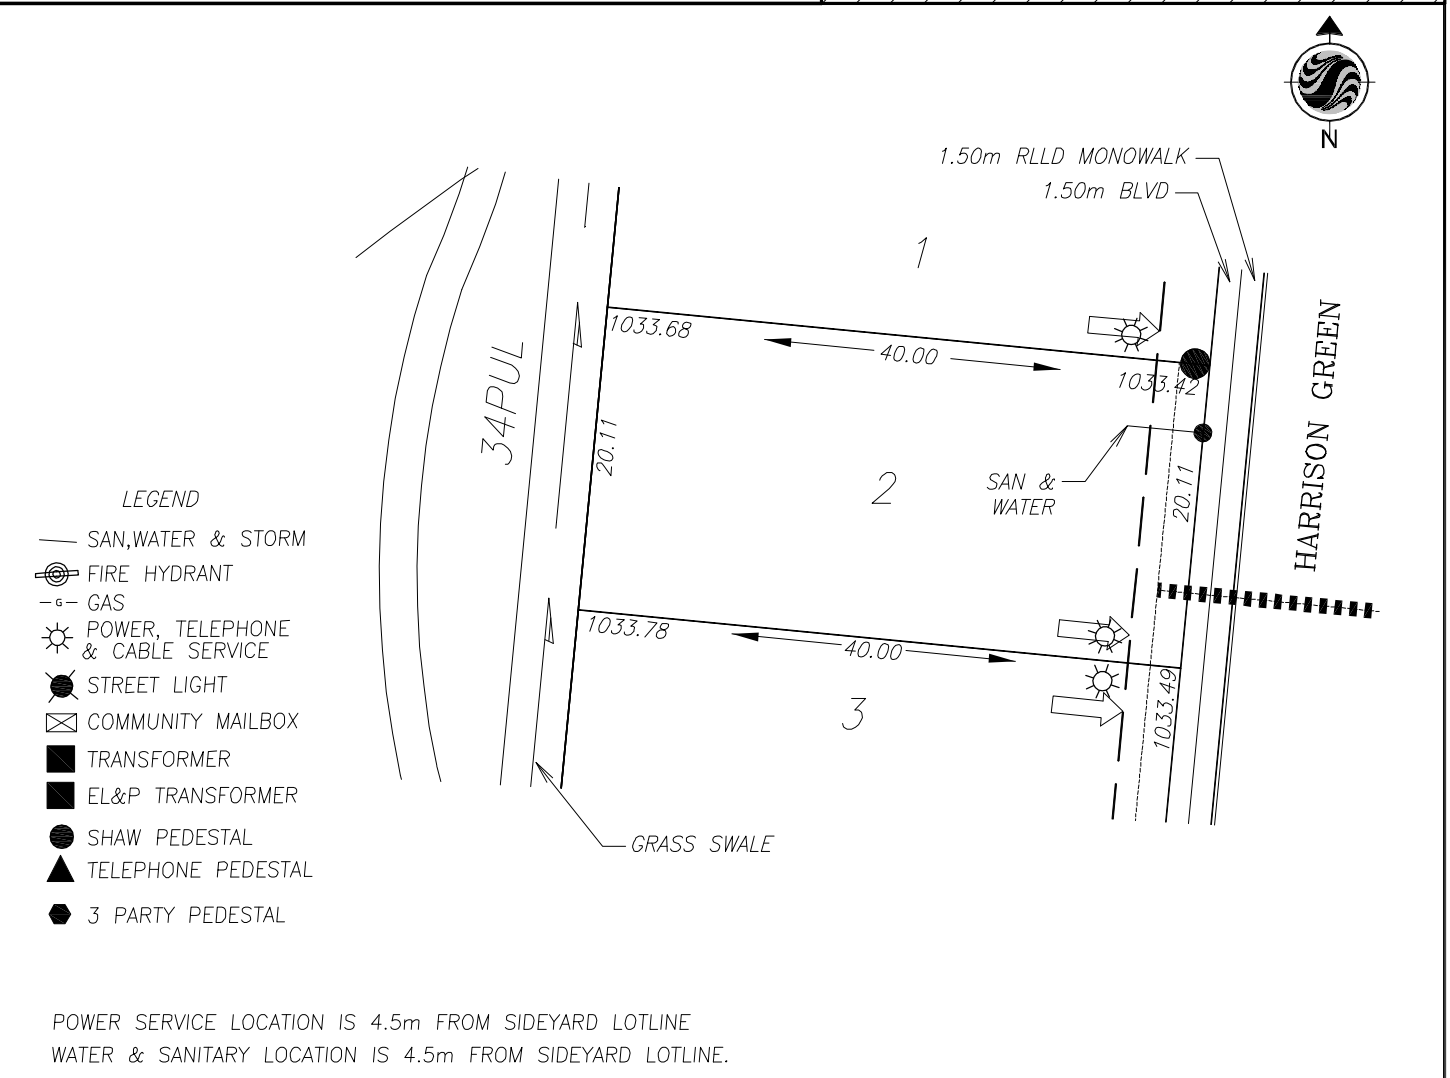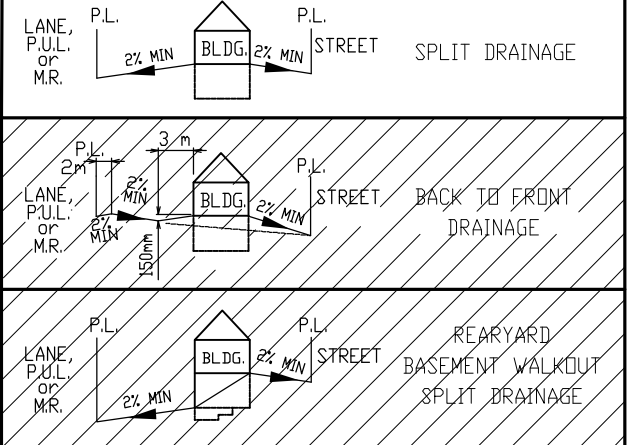

POWER SERVICE LOCATION IS 4.5m FROM SIDEYARD LOTLINE
WATER & SANITARY LOCATION IS 4.5m FROM SIDEYARD LOTLINE.

TOP OF FOOTING:
MAX. DEPTH BELOW AVERAGE SIDEWALK = 2.33
LOWEST ELEVATION = 1031.13

AS-BUILT SEWER INVERT ELEVATIONS:
SANITARY AT 4.0m INSIDE LOT = 1030.28
STORM AT 4.0m INSIDE LOT = N/A

CIVIC ADDRESS: 6 HARRISON GREEN
LOT: 2 BLOCK: 1 PLAN No.:
DEVELOPER: RICHARDSONS BROTHERS SCALE: 1:500
DRAWN BY: STANTEC CONSULTING LTD DATE: NOV 18, 2013
APPROVED BY: BARRY MASON DATE: NOV 18, 2013
RECEIVED BY: DATE:



DESIGN LANDSCAPE ELEVATIONS
ELEV. AT FRONT OF HOUSE = 1033.79
ELEV. AT REAR OF HOUSE = 1034.08

I CERTIFY THAT THE FINAL LANDSCAPE GRADE WILL BE (FRONT) (REAR)
SIGNATURE OF OWNER OR REPRESENTATIVE

BUILDING GRADE CERTIFICATE

Town of Olds
Issued by: No.

1. WHEN EXCAVATING IN A RIGHT OF WAY (EASEMENT), CHECK FOR UTILITIES.
2. STANDING AT THE WATER SHUTOFF AND FACING THE BUILDING, THE SANITARY SERVICE (PAINTED RED) IS ON THE LEFT SIDE OF THE WATER SERVICE; STORM SERVICE (PAINTED GREEN) IS ON THE RIGHT SIDE OF THE WATER SERVICE.
3. ALL DIMENSIONS ARE IN METRES AND DECIMALS THERE OF. THE ELEVATIONS ARE IN METRES ABOVE GEODETIC MEAN SEA LEVEL.
4. ELEVATIONS NOTED ON THE CERTIFICATE ARE WITHIN 100mm OF ACTUAL.
5. THE BUILDER MUST CONSTRUCT WITHIN 100mm OF THE DESIGN LANDSCAPE ELEVATION & ILLUSTRATED DRAINAGE PATTERNS UNLESS OTHERWISE APPROVED BY THE DEVELOPMENT OFFICER.
6. IF THE INFORMATION ON THIS CERTIFICATE HAS BEEN PREPARED BY A PRIVATE DEVELOPER OR THEIR AGENT, THE TOWN OF OLDS ACCEPTS NO RESPONSIBILITY FOR ITS ACCURACY.

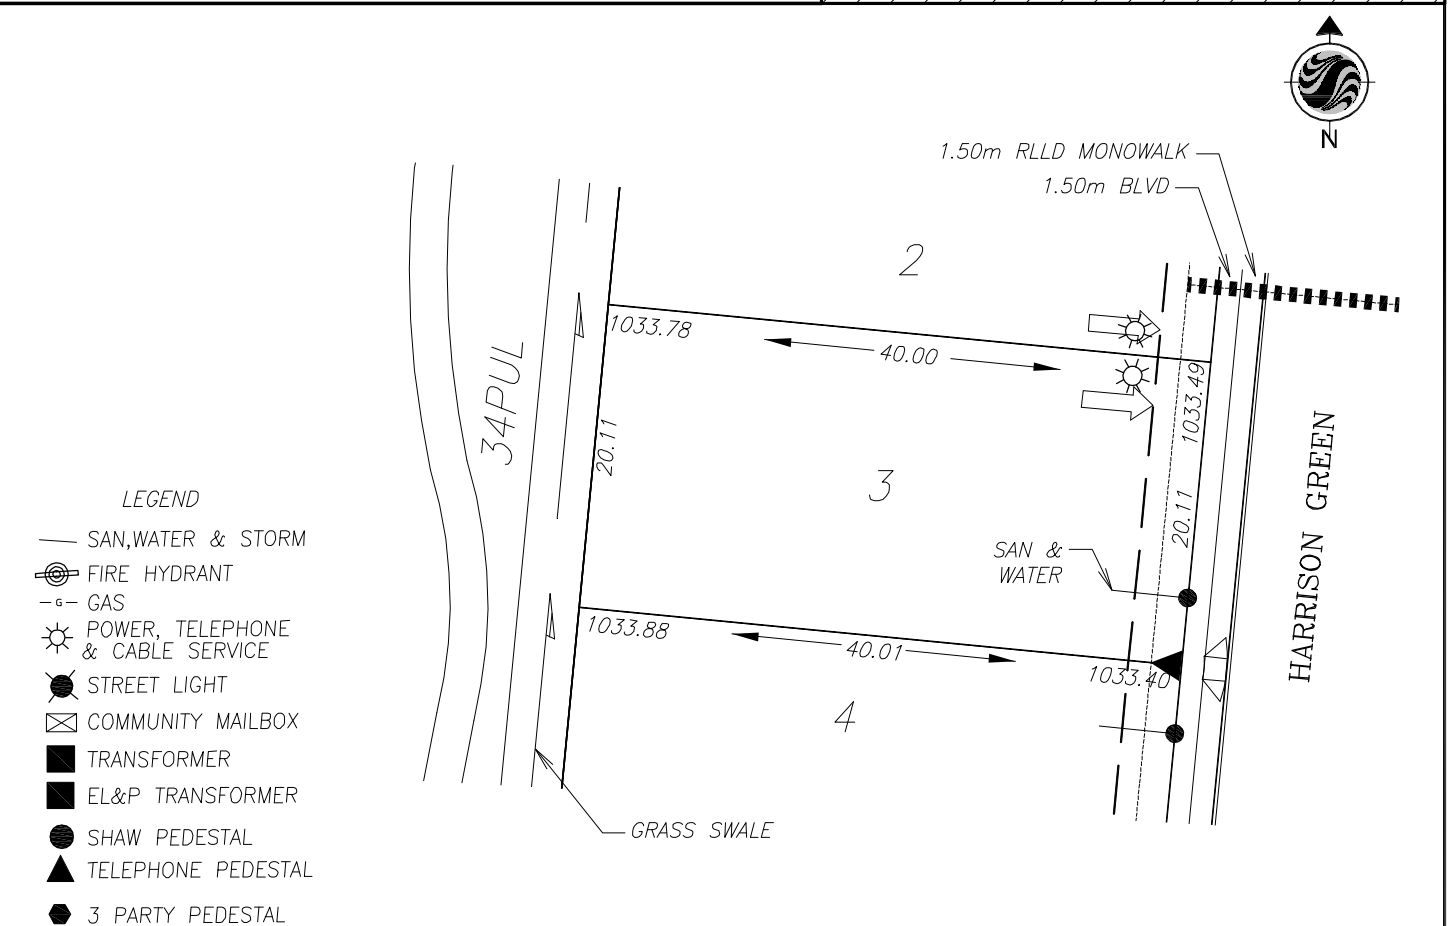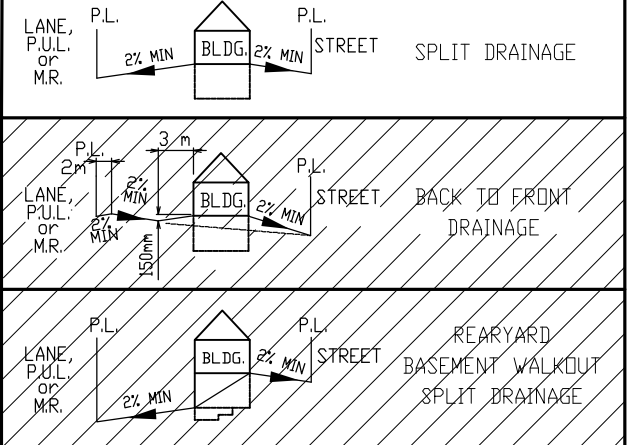

POWER SERVICE LOCATION IS 4.5m FROM SIDEYARD LOTLINE
WATER & SANITARY LOCATION IS 4.5m FROM SIDEYARD LOTLINE.

TOP OF FOOTING:
MAX. DEPTH BELOW AVERAGE SIDEWALK = 2.24
LOWEST ELEVATION = 1031.21

AS-BUILT SEWER INVERT ELEVATIONS:
SANITARY AT 4.0m INSIDE LOT = 1030.36
STORM AT 4.0m INSIDE LOT = N/A

CIVIC ADDRESS: 10 HARRISON GREEN
LOT: 3 BLOCK: 1 PLAN No.:
DEVELOPER: RICHARDSONS BROTHERS SCALE: 1:500
DRAWN BY: STANTEC CONSULTING LTD DATE: NOV 18, 2013
APPROVED BY: BARRY MASON DATE: NOV 18, 2013
RECEIVED BY: DATE:


DESIGN LANDSCAPE ELEVATIONS
ELEV. AT FRONT OF HOUSE = 1033.79
ELEV. AT REAR OF HOUSE = 1034.18

I CERTIFY THAT THE FINAL LANDSCAPE GRADE WILL BE (FRONT) _____
(REAR) _____
SIGNATURE OF OWNER OR REPRESENTATIVE _____


BUILDING GRADE CERTIFICATE

Town of Olds
Issued by: No.

1. WHEN EXCAVATING IN A RIGHT OF WAY (EASEMENT), CHECK FOR UTILITIES.
2. STANDING AT THE WATER SHUTOFF AND FACING THE BUILDING, THE SANITARY SERVICE (PAINTED RED) IS ON THE LEFT SIDE OF THE WATER SERVICE; STORM SERVICE (PAINTED GREEN) IS ON THE RIGHT SIDE OF THE WATER SERVICE.
3. ALL DIMENSIONS ARE IN METRES AND DECIMALS THERE OF. THE ELEVATIONS ARE IN METRES ABOVE GEODETIC MEAN SEA LEVEL.
4. ELEVATIONS NOTED ON THE CERTIFICATE ARE WITHIN 100mm OF ACTUAL.
5. THE BUILDER MUST CONSTRUCT WITHIN 100mm OF THE DESIGN LANDSCAPE ELEVATION & ILLUSTRATED DRAINAGE PATTERNS UNLESS OTHERWISE APPROVED BY THE DEVELOPMENT OFFICER.
6. IF THE INFORMATION ON THIS CERTIFICATE HAS BEEN PREPARED BY A PRIVATE DEVELOPER OR THEIR AGENT, THE TOWN OF OLDS ACCEPTS NO RESPONSIBILITY FOR ITS ACCURACY.

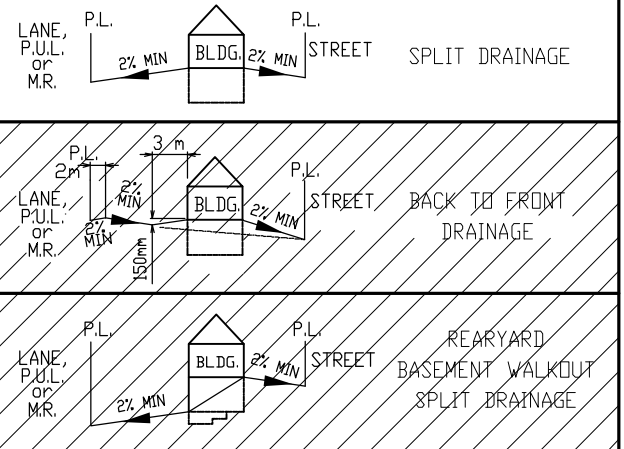

- LEGEND**
- SAN, WATER & STORM
 - ⊙ FIRE HYDRANT
 - - - GAS
 - ☀ POWER, TELEPHONE & CABLE SERVICE
 - ⊙ STREET LIGHT
 - ⊠ COMMUNITY MAILBOX
 - TRANSFORMER
 - EL&P TRANSFORMER
 - SHAW PEDESTAL
 - ▲ TELEPHONE PEDESTAL
 - ◆ 3 PARTY PEDESTAL

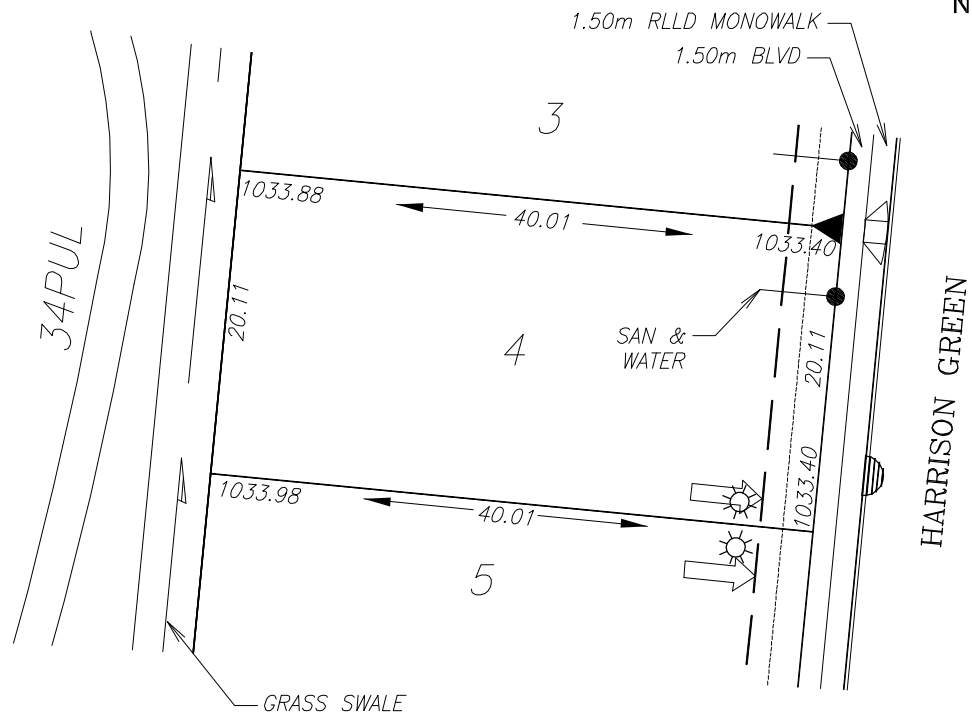

POWER SERVICE LOCATION IS 4.5m FROM SIDERYARD LOTLINE
WATER & SANITARY LOCATION IS 4.5m FROM SIDERYARD LOTLINE.

TOP OF FOOTING:
MAX. DEPTH BELOW AVERAGE SIDEWALK = 2.11
LOWEST ELEVATION = 1031.29

AS-BUILT SEWER INVERT ELEVATIONS:
SANITARY AT 4.0m INSIDE LOT = 1030.44
STORM AT 4.0m INSIDE LOT = N/A

CIVIC ADDRESS: 14 HARRISON GREEN
LOT: 4 BLOCK: 1 PLAN No.:
DEVELOPER: RICHARDSONS BROTHERS SCALE: 1:500
DRAWN BY: STANTEC CONSULTING LTD DATE: NOV 18, 2013
APPROVED BY: BARRY MASON DATE: NOV 18, 2013
RECEIVED BY: DATE:


DESIGN LANDSCAPE ELEVATIONS
ELEV. AT FRONT OF HOUSE = 1033.70
ELEV. AT REAR OF HOUSE = 1034.28

I CERTIFY THAT THE FINAL LANDSCAPE GRADE WILL BE (FRONT) _____
(REAR) _____
SIGNATURE OF OWNER OR REPRESENTATIVE _____


BUILDING GRADE CERTIFICATE

Town of Olds
Issued by: No.

1. WHEN EXCAVATING IN A RIGHT OF WAY (EASEMENT), CHECK FOR UTILITIES.
2. STANDING AT THE WATER SHUTOFF AND FACING THE BUILDING, THE SANITARY SERVICE (PAINTED RED) IS ON THE LEFT SIDE OF THE WATER SERVICE; STORM SERVICE (PAINTED GREEN) IS ON THE RIGHT SIDE OF THE WATER SERVICE.
3. ALL DIMENSIONS ARE IN METRES AND DECIMALS THERE OF. THE ELEVATIONS ARE IN METRES ABOVE GEODETIC MEAN SEA LEVEL.
4. ELEVATIONS NOTED ON THE CERTIFICATE ARE WITHIN 100mm OF ACTUAL.
5. THE BUILDER MUST CONSTRUCT WITHIN 100mm OF THE DESIGN LANDSCAPE ELEVATION & ILLUSTRATED DRAINAGE PATTERNS UNLESS OTHERWISE APPROVED BY THE DEVELOPMENT OFFICER.
6. IF THE INFORMATION ON THIS CERTIFICATE HAS BEEN PREPARED BY A PRIVATE DEVELOPER OR THEIR AGENT, THE TOWN OF OLDS ACCEPTS NO RESPONSIBILITY FOR ITS ACCURACY.

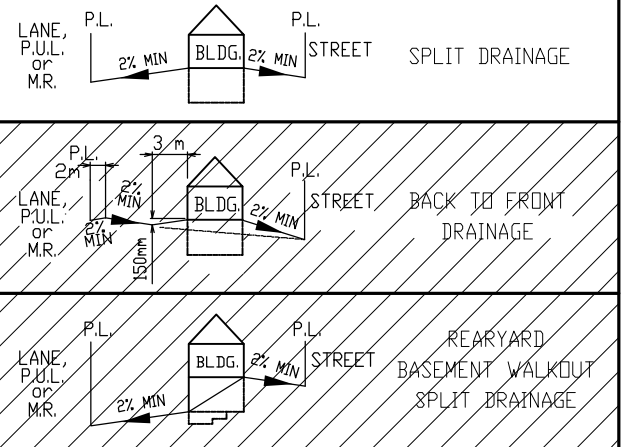

- LEGEND**
- SAN, WATER & STORM
 - ⊙ FIRE HYDRANT
 - G- GAS
 - ☀ POWER, TELEPHONE & CABLE SERVICE
 - STREET LIGHT
 - ⊠ COMMUNITY MAILBOX
 - TRANSFORMER
 - EL&P TRANSFORMER
 - SHAW PEDESTAL
 - ▲ TELEPHONE PEDESTAL
 - 3 PARTY PEDESTAL

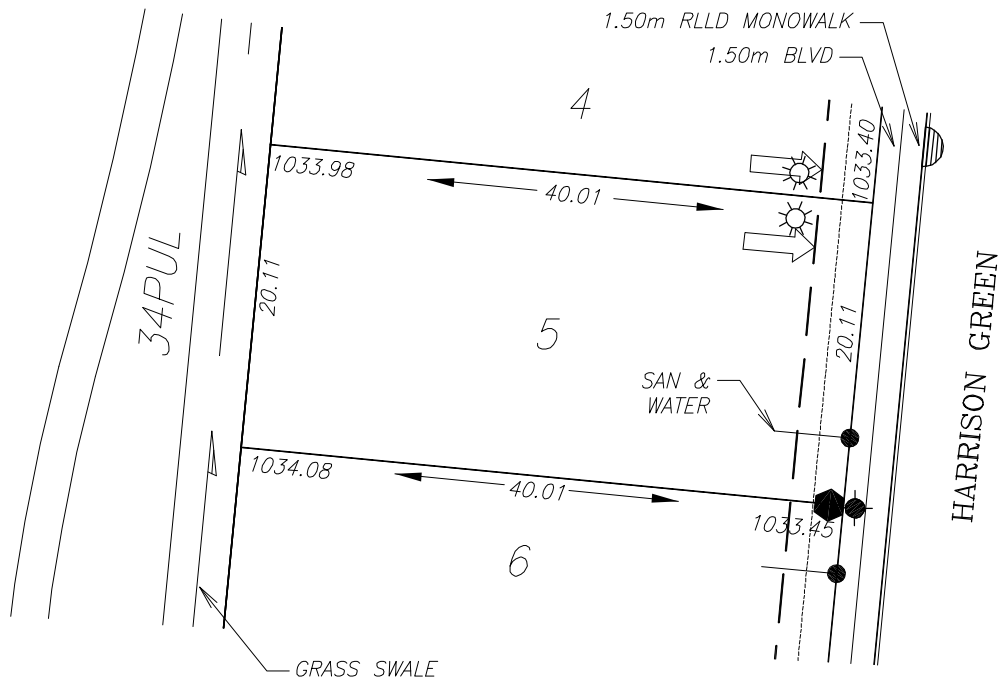

POWER SERVICE LOCATION IS 4.5m FROM SIDEYARD LOTLINE
WATER & SANITARY LOCATION IS 4.5m FROM SIDEYARD LOTLINE.

TOP OF FOOTING:
MAX. DEPTH BELOW AVERAGE SIDEWALK = 2.01
LOWEST ELEVATION = 1031.42

AS-BUILT SEWER INVERT ELEVATIONS:
SANITARY AT 4.0m INSIDE LOT = 1030.57
STORM AT 4.0m INSIDE LOT = N/A

CIVIC ADDRESS: 18 HARRISON GREEN
LOT: 5 BLOCK: 1 PLAN No.:
DEVELOPER: RICHARDSONS BROTHERS SCALE: 1:500
DRAWN BY: STANTEC CONSULTING LTD DATE: NOV 18, 2013
APPROVED BY: BARRY MASON DATE: NOV 18, 2013
RECEIVED BY: DATE:



DESIGN LANDSCAPE ELEVATIONS
ELEV. AT FRONT OF HOUSE = 1033.75
ELEV. AT REAR OF HOUSE = 1034.38

I CERTIFY THAT THE FINAL LANDSCAPE GRADE WILL BE (FRONT) (REAR)
SIGNATURE OF OWNER OR REPRESENTATIVE

BUILDING GRADE CERTIFICATE

Town of Olds
Issued by: No.

1. WHEN EXCAVATING IN A RIGHT OF WAY (EASEMENT), CHECK FOR UTILITIES.
2. STANDING AT THE WATER SHUTOFF AND FACING THE BUILDING, THE SANITARY SERVICE (PAINTED RED) IS ON THE LEFT SIDE OF THE WATER SERVICE; STORM SERVICE (PAINTED GREEN) IS ON THE RIGHT SIDE OF THE WATER SERVICE.
3. ALL DIMENSIONS ARE IN METRES AND DECIMALS THERE OF. THE ELEVATIONS ARE IN METRES ABOVE GEODETIC MEAN SEA LEVEL.
4. ELEVATIONS NOTED ON THE CERTIFICATE ARE WITHIN 100mm OF ACTUAL.
5. THE BUILDER MUST CONSTRUCT WITHIN 100mm OF THE DESIGN LANDSCAPE ELEVATION & ILLUSTRATED DRAINAGE PATTERNS UNLESS OTHERWISE APPROVED BY THE DEVELOPMENT OFFICER.
6. IF THE INFORMATION ON THIS CERTIFICATE HAS BEEN PREPARED BY A PRIVATE DEVELOPER OR THEIR AGENT, THE TOWN OF OLDS ACCEPTS NO RESPONSIBILITY FOR ITS ACCURACY.

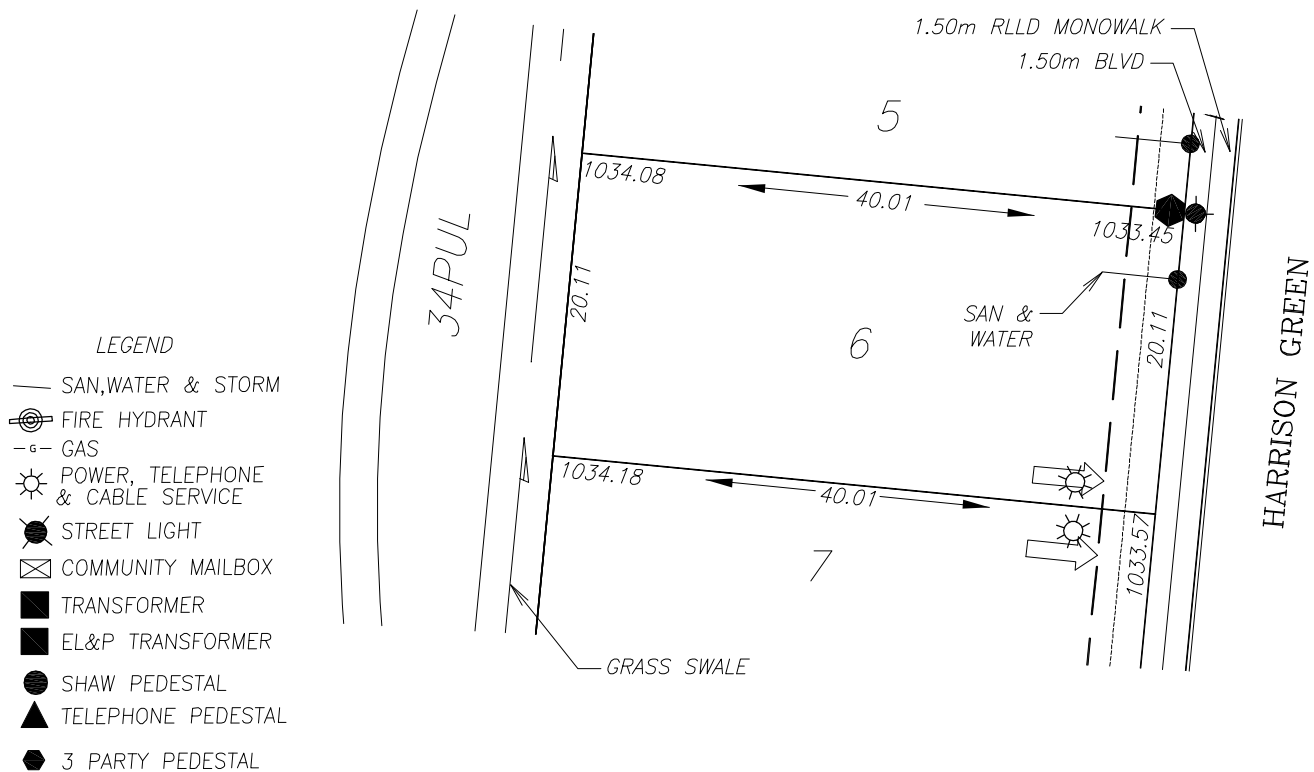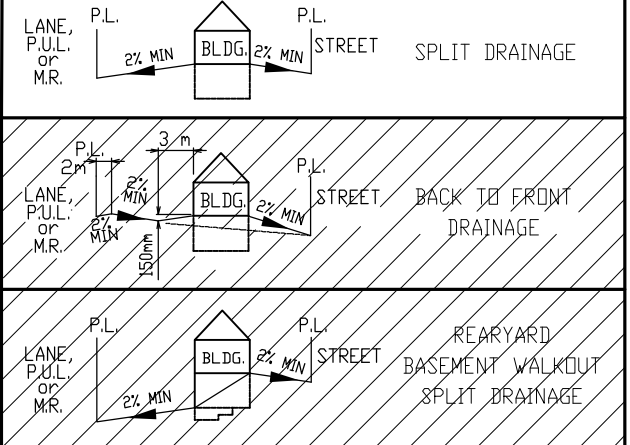

POWER SERVICE LOCATION IS 4.5m FROM SIDEYARD LOTLINE
WATER & SANITARY LOCATION IS 4.5m FROM SIDEYARD LOTLINE.

TOP OF FOOTING:
MAX. DEPTH BELOW AVERAGE SIDEWALK = 2.00
LOWEST ELEVATION = 1031.51

AS-BUILT SEWER INVERT ELEVATIONS:
SANITARY AT 4.0m INSIDE LOT = 1030.66
STORM AT 4.0m INSIDE LOT = N/A

CIVIC ADDRESS: 22 HARRISON GREEN
LOT: 6 BLOCK: 1 PLAN No.:
DEVELOPER: RICHARDSONS BROTHERS SCALE: 1:500
DRAWN BY: STANTEC CONSULTING LTD DATE: NOV 18, 2013
APPROVED BY: BARRY MASON DATE: NOV 18, 2013
RECEIVED BY: DATE:


DESIGN LANDSCAPE ELEVATIONS
ELEV. AT FRONT OF HOUSE = 1033.87
ELEV. AT REAR OF HOUSE = 1034.48

I CERTIFY THAT THE FINAL LANDSCAPE GRADE WILL BE (FRONT) (REAR)
SIGNATURE OF OWNER OR REPRESENTATIVE


BUILDING GRADE CERTIFICATE

Town of Olds
Issued by: No.

1. WHEN EXCAVATING IN A RIGHT OF WAY (EASEMENT), CHECK FOR UTILITIES.
2. STANDING AT THE WATER SHUTOFF AND FACING THE BUILDING, THE SANITARY SERVICE (PAINTED RED) IS ON THE LEFT SIDE OF THE WATER SERVICE; STORM SERVICE (PAINTED GREEN) IS ON THE RIGHT SIDE OF THE WATER SERVICE.
3. ALL DIMENSIONS ARE IN METRES AND DECIMALS THERE OF. THE ELEVATIONS ARE IN METRES ABOVE GEODETIC MEAN SEA LEVEL.
4. ELEVATIONS NOTED ON THE CERTIFICATE ARE WITHIN 100mm OF ACTUAL.
5. THE BUILDER MUST CONSTRUCT WITHIN 100mm OF THE DESIGN LANDSCAPE ELEVATION & ILLUSTRATED DRAINAGE PATTERNS UNLESS OTHERWISE APPROVED BY THE DEVELOPMENT OFFICER.
6. IF THE INFORMATION ON THIS CERTIFICATE HAS BEEN PREPARED BY A PRIVATE DEVELOPER OR THEIR AGENT, THE TOWN OF OLDS ACCEPTS NO RESPONSIBILITY FOR ITS ACCURACY.

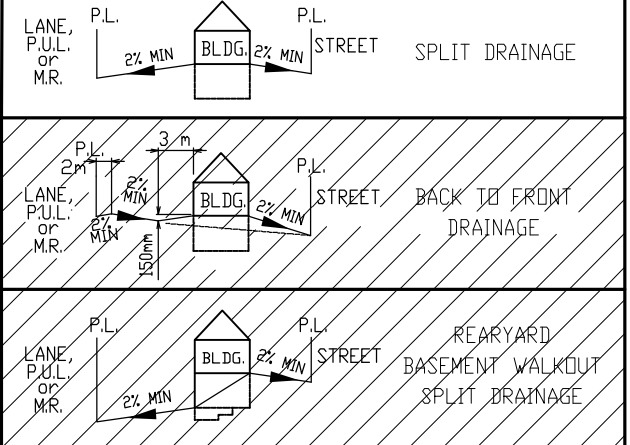

- LEGEND**
- SAN, WATER & STORM
 - ⊙ FIRE HYDRANT
 - G- GAS
 - ☀ POWER, TELEPHONE & CABLE SERVICE
 - STREET LIGHT
 - ⊠ COMMUNITY MAILBOX
 - TRANSFORMER
 - EL&P TRANSFORMER
 - SHAW PEDESTAL
 - ▲ TELEPHONE PEDESTAL
 - 3 PARTY PEDESTAL

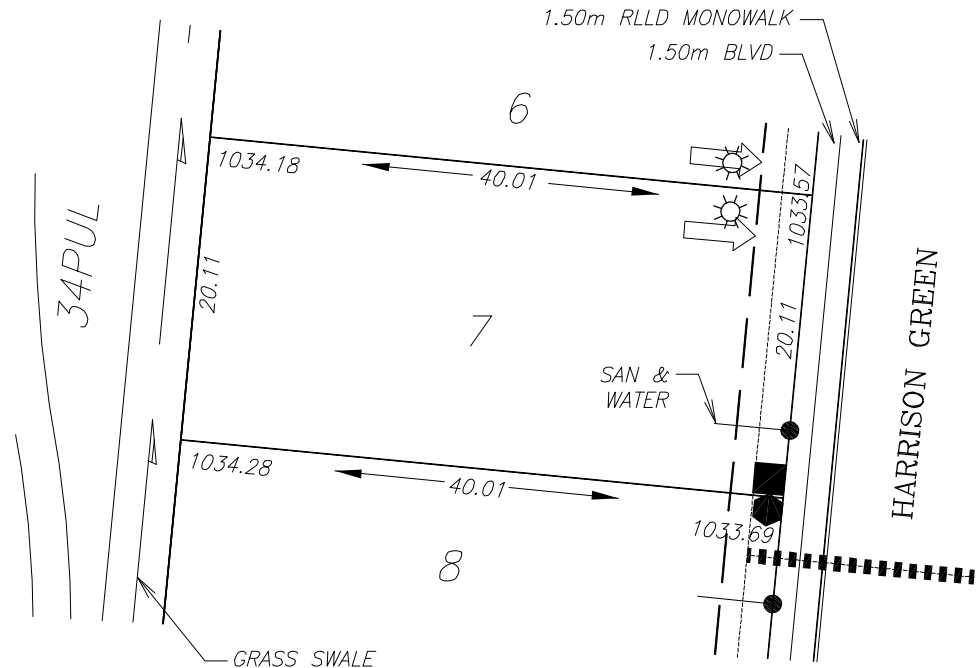

POWER SERVICE LOCATION IS 4.5m FROM SIDEYARD LOTLINE
WATER & SANITARY LOCATION IS 4.5m FROM SIDEYARD LOTLINE.

TOP OF FOOTING:
MAX. DEPTH BELOW AVERAGE SIDEWALK = 2.04
LOWEST ELEVATION = 1031.59

AS-BUILT SEWER INVERT ELEVATIONS:
SANITARY AT 4.0m INSIDE LOT = 1030.74
STORM AT 4.0m INSIDE LOT = N/A

CIVIC ADDRESS: 26 HARRISON GREEN
LOT: 7 BLOCK: 1 PLAN No.:
DEVELOPER: RICHARDSONS BROTHERS SCALE: 1:500
DRAWN BY: STANTEC CONSULTING LTD DATE: NOV 18, 2013
APPROVED BY: BARRY MASON DATE: NOV 18, 2013
RECEIVED BY: DATE:


DESIGN LANDSCAPE ELEVATIONS
ELEV. AT FRONT OF HOUSE = 1033.99
ELEV. AT REAR OF HOUSE = 1034.58

I CERTIFY THAT THE FINAL LANDSCAPE GRADE WILL BE (FRONT) _____
(REAR) _____
SIGNATURE OF OWNER OR REPRESENTATIVE _____


BUILDING GRADE CERTIFICATE

Town of Olds
Issued by: No.

1. WHEN EXCAVATING IN A RIGHT OF WAY (EASEMENT), CHECK FOR UTILITIES.
2. STANDING AT THE WATER SHUTOFF AND FACING THE BUILDING, THE SANITARY SERVICE (PAINTED RED) IS ON THE LEFT SIDE OF THE WATER SERVICE; STORM SERVICE (PAINTED GREEN) IS ON THE RIGHT SIDE OF THE WATER SERVICE.
3. ALL DIMENSIONS ARE IN METRES AND DECIMALS THERE OF. THE ELEVATIONS ARE IN METRES ABOVE GEODETIC MEAN SEA LEVEL.
4. ELEVATIONS NOTED ON THE CERTIFICATE ARE WITHIN 100mm OF ACTUAL.
5. THE BUILDER MUST CONSTRUCT WITHIN 100mm OF THE DESIGN LANDSCAPE ELEVATION & ILLUSTRATED DRAINAGE PATTERNS UNLESS OTHERWISE APPROVED BY THE DEVELOPMENT OFFICER.
6. IF THE INFORMATION ON THIS CERTIFICATE HAS BEEN PREPARED BY A PRIVATE DEVELOPER OR THEIR AGENT, THE TOWN OF OLDS ACCEPTS NO RESPONSIBILITY FOR ITS ACCURACY.

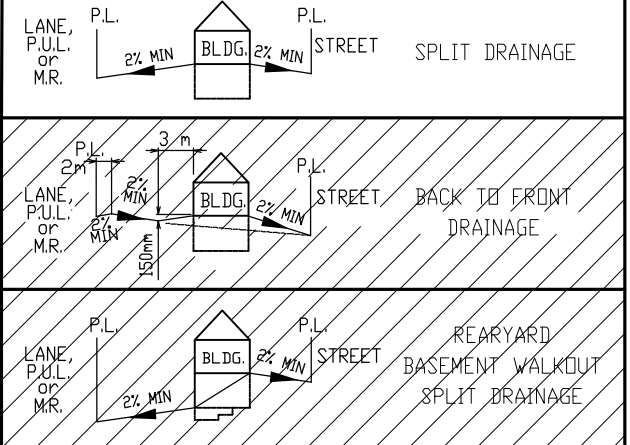

- LEGEND
- SAN, WATER & STORM
 - ⊙ FIRE HYDRANT
 - G- GAS
 - ☀ POWER, TELEPHONE & CABLE SERVICE
 - STREET LIGHT
 - ⊠ COMMUNITY MAILBOX
 - TRANSFORMER
 - EL&P TRANSFORMER
 - SHAW PEDESTAL
 - ▲ TELEPHONE PEDESTAL
 - 3 PARTY PEDESTAL

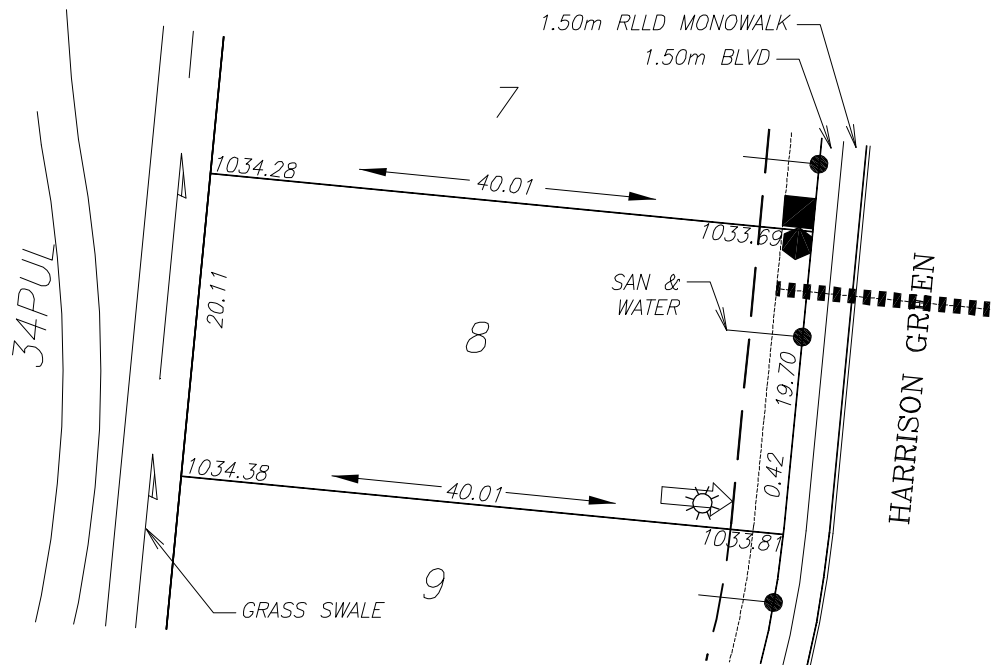

POWER SERVICE LOCATION IS 4.5m FROM SIDEYARD LOTLINE
WATER & SANITARY LOCATION IS 4.5m FROM SIDEYARD LOTLINE.

TOP OF FOOTING:
MAX. DEPTH BELOW AVERAGE SIDEWALK = 2.08
LOWEST ELEVATION = 1031.67

AS-BUILT SEWER INVERT ELEVATIONS:
SANITARY AT 4.0m INSIDE LOT = 1030.82
STORM AT 4.0m INSIDE LOT = N/A

CIVIC ADDRESS: 30 HARRISON GREEN
LOT: 8 BLOCK: 1 PLAN No.:
DEVELOPER: RICHARDSONS BROTHERS SCALE: 1:500
DRAWN BY: STANTEC CONSULTING LTD DATE: NOV 18, 2013
APPROVED BY: BARRY MASON DATE: NOV 18, 2013
RECEIVED BY: DATE:


DESIGN LANDSCAPE ELEVATIONS
ELEV. AT FRONT OF HOUSE = 1034.11
ELEV. AT REAR OF HOUSE = 1034.68

I CERTIFY THAT THE FINAL LANDSCAPE GRADE WILL BE (FRONT) _____
(REAR) _____
SIGNATURE OF OWNER OR REPRESENTATIVE _____


BUILDING GRADE CERTIFICATE

Town of Olds
Issued by: No.

1. WHEN EXCAVATING IN A RIGHT OF WAY (EASEMENT), CHECK FOR UTILITIES.
2. STANDING AT THE WATER SHUTOFF AND FACING THE BUILDING, THE SANITARY SERVICE (PAINTED RED) IS ON THE LEFT SIDE OF THE WATER SERVICE; STORM SERVICE (PAINTED GREEN) IS ON THE RIGHT SIDE OF THE WATER SERVICE.
3. ALL DIMENSIONS ARE IN METRES AND DECIMALS THERE OF. THE ELEVATIONS ARE IN METRES ABOVE GEODETIC MEAN SEA LEVEL.
4. ELEVATIONS NOTED ON THE CERTIFICATE ARE WITHIN 100mm OF ACTUAL.
5. THE BUILDER MUST CONSTRUCT WITHIN 100mm OF THE DESIGN LANDSCAPE ELEVATION & ILLUSTRATED DRAINAGE PATTERNS UNLESS OTHERWISE APPROVED BY THE DEVELOPMENT OFFICER.
6. IF THE INFORMATION ON THIS CERTIFICATE HAS BEEN PREPARED BY A PRIVATE DEVELOPER OR THEIR AGENT, THE TOWN OF OLDS ACCEPTS NO RESPONSIBILITY FOR ITS ACCURACY.

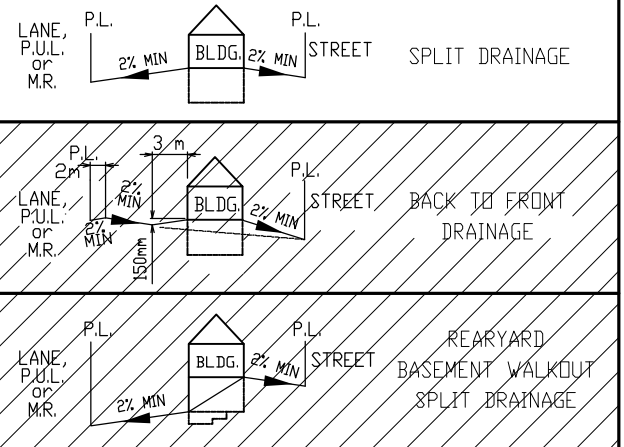

- LEGEND
- SAN, WATER & STORM
 - ⊙ FIRE HYDRANT
 - G- GAS
 - ☀ POWER, TELEPHONE & CABLE SERVICE
 - STREET LIGHT
 - ⊠ COMMUNITY MAILBOX
 - TRANSFORMER
 - EL&P TRANSFORMER
 - SHAW PEDESTAL
 - ▲ TELEPHONE PEDESTAL
 - 3 PARTY PEDESTAL

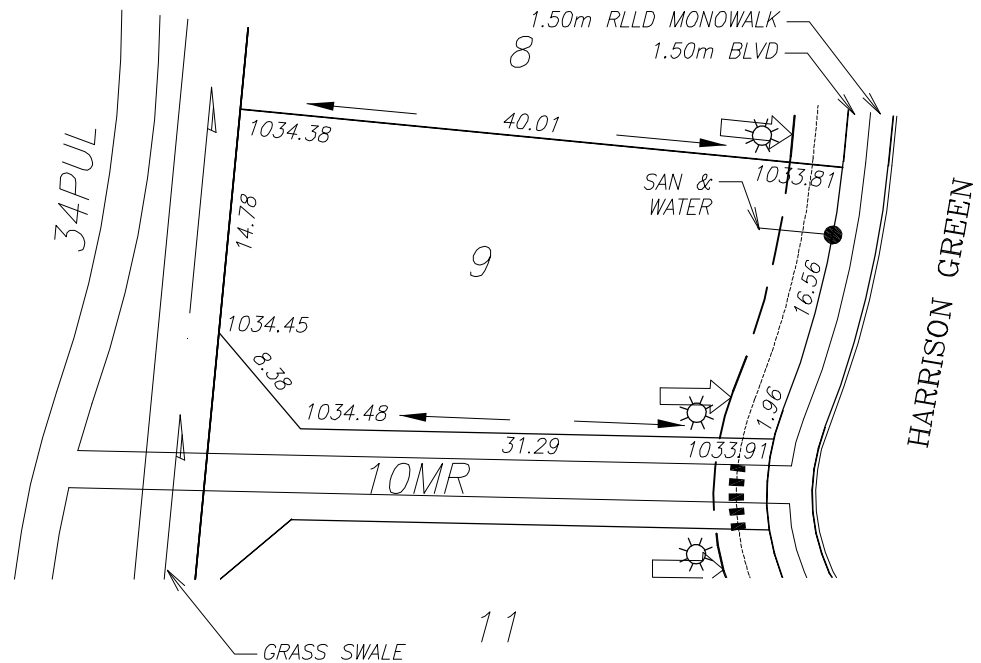

POWER SERVICE LOCATION IS 4.5m FROM SIDEYARD LOTLINE
WATER & SANITARY LOCATION IS 4.5m FROM SIDEYARD LOTLINE.

TOP OF FOOTING:
MAX. DEPTH BELOW AVERAGE SIDEWALK = 1.09
LOWEST ELEVATION = 1032.77

AS-BUILT SEWER INVERT ELEVATIONS:
SANITARY AT 4.0m INSIDE LOT = 1031.92
STORM AT 4.0m INSIDE LOT = N/A

CIVIC ADDRESS: 34 HARRISON GREEN
LOT: 9 BLOCK: 1 PLAN No.:
DEVELOPER: RICHARDSONS BROTHERS SCALE: 1:500
DRAWN BY: STANTEC CONSULTING LTD DATE: NOV 18, 2013
APPROVED BY: BARRY MASON DATE: NOV 18, 2013
RECEIVED BY: DATE:


DESIGN LANDSCAPE ELEVATIONS
ELEV. AT FRONT OF HOUSE = 1034.21
ELEV. AT REAR OF HOUSE = 1034.78

I CERTIFY THAT THE FINAL LANDSCAPE GRADE WILL BE (FRONT) _____
(REAR) _____
SIGNATURE OF OWNER OR REPRESENTATIVE _____

Town of Olds	
Issued by:	No.

- Diagram illustrating three scenarios for split drainage:


 - Top Scenario:** Front split drainage. The building (BLDG.) is shown with a 2% MIN slope to the STREET. The P.L. (Proposed Level) is shown with a 2% MIN slope to the building.
 - Middle Scenario:** BACK TO FRONT DRAINAGE. The building (BLDG.) is shown with a 2% MIN slope to the STREET. The P.L. is shown with a 2% MIN slope to the building. A 150mm minimum depth requirement is indicated for the rear yard area.
 - Bottom Scenario:** REAR YARD BASEMENT WALKOUT SPLIT DRAINAGE. The building (BLDG.) is shown with a 2% MIN slope to the STREET. The P.L. is shown with a 2% MIN slope to the building.

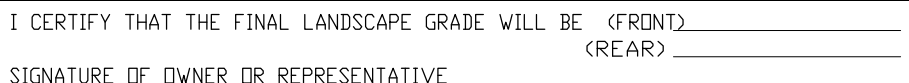

Town of Olds	
Issued by:	No.

- Diagram illustrating three split drainage scenarios for a building (BLDG.) adjacent to a street (STREET) and a lane (LANE, P.U.L. or M.R.).




 - Scenario 1 (Top):** Shows a building with a front yard (3m wide) and a rear yard (2m wide). The front yard has a 2% minimum slope to the street. The rear yard has a 2% minimum slope to the street. The building has a 2% minimum slope to the street.
 - Scenario 2 (Middle):** Shows a building with a front yard (3m wide) and a rear yard (2m wide). The front yard has a 2% minimum slope to the street. The rear yard has a 2% minimum slope to the street. The building has a 2% minimum slope to the street.
 - Scenario 3 (Bottom):** Shows a building with a front yard (3m wide) and a rear yard (2m wide). The front yard has a 2% minimum slope to the street. The rear yard has a 2% minimum slope to the street. The building has a 2% minimum slope to the street.

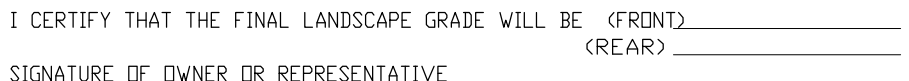

BUILDING GRADE CERTIFICATE

Town of Olds
Issued by: No.

1. WHEN EXCAVATING IN A RIGHT OF WAY (EASEMENT), CHECK FOR UTILITIES.
2. STANDING AT THE WATER SHUTOFF AND FACING THE BUILDING, THE SANITARY SERVICE (PAINTED RED) IS ON THE LEFT SIDE OF THE WATER SERVICE; STORM SERVICE (PAINTED GREEN) IS ON THE RIGHT SIDE OF THE WATER SERVICE.
3. ALL DIMENSIONS ARE IN METRES AND DECIMALS THERE OF. THE ELEVATIONS ARE IN METRES ABOVE GEODETIC MEAN SEA LEVEL.
4. ELEVATIONS NOTED ON THE CERTIFICATE ARE WITHIN 100mm OF ACTUAL.
5. THE BUILDER MUST CONSTRUCT WITHIN 100mm OF THE DESIGN LANDSCAPE ELEVATION & ILLUSTRATED DRAINAGE PATTERNS UNLESS OTHERWISE APPROVED BY THE DEVELOPMENT OFFICER.
6. IF THE INFORMATION ON THIS CERTIFICATE HAS BEEN PREPARED BY A PRIVATE DEVELOPER OR THEIR AGENT, THE TOWN OF OLDS ACCEPTS NO RESPONSIBILITY FOR ITS ACCURACY.

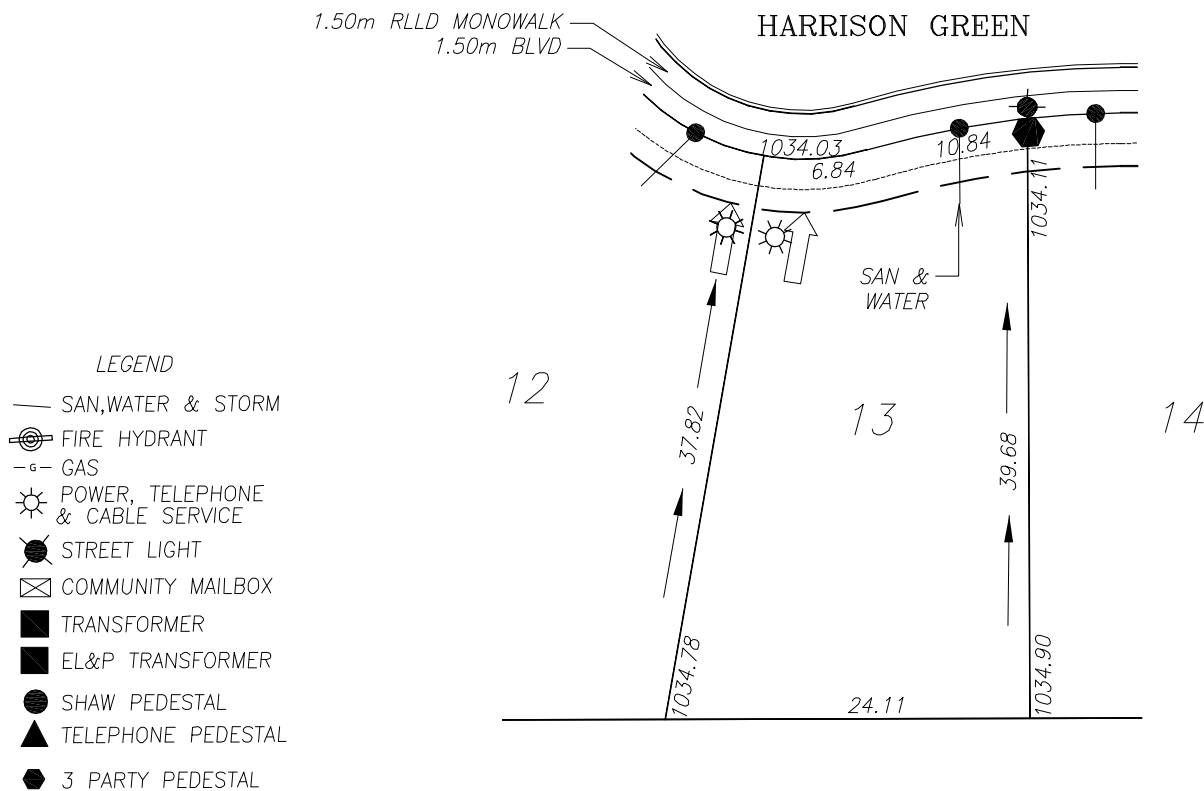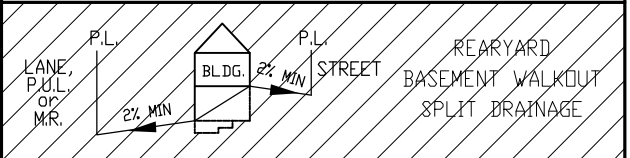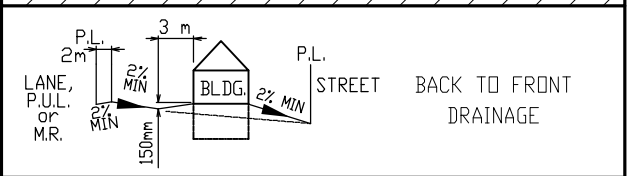

POWER SERVICE LOCATION IS 4.5m FROM SIDEYARD LOTLINE
WATER & SANITARY LOCATION IS 4.5m FROM SIDEYARD LOTLINE.

TOP OF FOOTING:
MAX. DEPTH BELOW AVERAGE SIDEWALK = 2.11
LOWEST ELEVATION = 1031.96

AS-BUILT SEWER INVERT ELEVATIONS:
SANITARY AT 4.0m INSIDE LOT = 1031.11
STORM AT 4.0m INSIDE LOT = N/A

CIVIC ADDRESS: 46 HARRISON GREEN
LOT: 13 BLOCK: 1 PLAN No.:
DEVELOPER: RICHARDSONS BROTHERS SCALE: 1:500
DRAWN BY: STANTEC CONSULTING LTD DATE: NOV 18, 2013
APPROVED BY: BARRY MASON DATE: NOV 18, 2013
RECEIVED BY: DATE:



DESIGN LANDSCAPE ELEVATIONS
ELEV. AT FRONT OF HOUSE = 1034.41
ELEV. AT REAR OF HOUSE = 1034.80

I CERTIFY THAT THE FINAL LANDSCAPE GRADE WILL BE (FRONT) _____
(REAR) _____
SIGNATURE OF OWNER OR REPRESENTATIVE _____


BUILDING GRADE CERTIFICATE

Town of Olds
Issued by: No.

1. WHEN EXCAVATING IN A RIGHT OF WAY (EASEMENT), CHECK FOR UTILITIES.
2. STANDING AT THE WATER SHUTOFF AND FACING THE BUILDING, THE SANITARY SERVICE (PAINTED RED) IS ON THE LEFT SIDE OF THE WATER SERVICE; STORM SERVICE (PAINTED GREEN) IS ON THE RIGHT SIDE OF THE WATER SERVICE.
3. ALL DIMENSIONS ARE IN METRES AND DECIMALS THERE OF. THE ELEVATIONS ARE IN METRES ABOVE GEODETIC MEAN SEA LEVEL.
4. ELEVATIONS NOTED ON THE CERTIFICATE ARE WITHIN 100mm OF ACTUAL.
5. THE BUILDER MUST CONSTRUCT WITHIN 100mm OF THE DESIGN LANDSCAPE ELEVATION & ILLUSTRATED DRAINAGE PATTERNS UNLESS OTHERWISE APPROVED BY THE DEVELOPMENT OFFICER.
6. IF THE INFORMATION ON THIS CERTIFICATE HAS BEEN PREPARED BY A PRIVATE DEVELOPER OR THEIR AGENT, THE TOWN OF OLDS ACCEPTS NO RESPONSIBILITY FOR ITS ACCURACY.

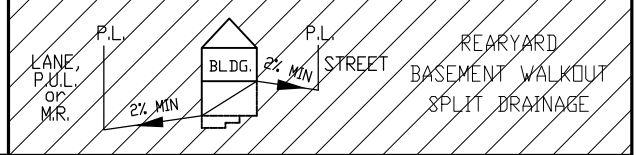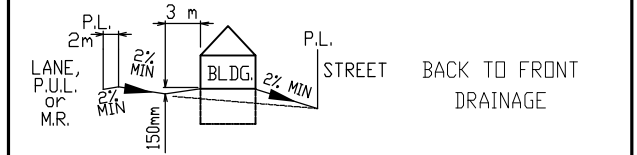

HARRISON GREEN

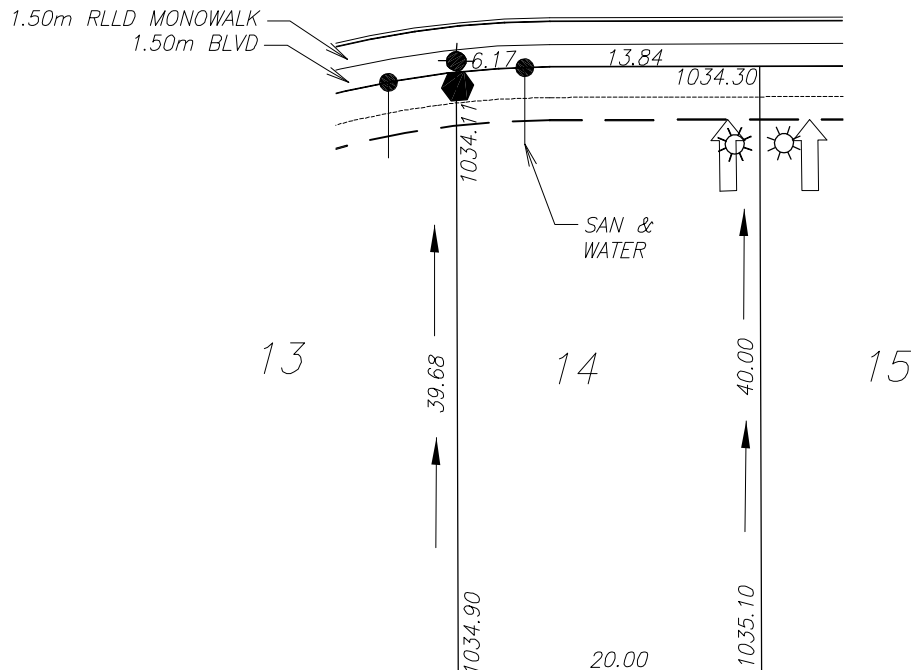

LEGEND

- SAN, WATER & STORM
- ⊙ FIRE HYDRANT
- - - GAS
- ☀ POWER, TELEPHONE & CABLE SERVICE
- ⦿ STREET LIGHT
- ⊠ COMMUNITY MAILBOX
- TRANSFORMER
- EL&P TRANSFORMER
- SHAW PEDESTAL
- ▲ TELEPHONE PEDESTAL
- ◆ 3 PARTY PEDESTAL

POWER SERVICE LOCATION IS 4.5m FROM SIDEYARD LOTLINE
WATER & SANITARY LOCATION IS 4.5m FROM SIDEYARD LOTLINE.

TOP OF FOOTING:
MAX. DEPTH BELOW AVERAGE SIDEWALK = 2.21
LOWEST ELEVATION = 1032.00

AS-BUILT SEWER INVERT ELEVATIONS:
SANITARY AT 4.0m INSIDE LOT = 1031.15
STORM AT 4.0m INSIDE LOT = N/A

CIVIC ADDRESS: 50 HARRISON GREEN
LOT: 14 BLOCK: 1 PLAN No.:
DEVELOPER: RICHARDSONS BROTHERS SCALE: 1:500
DRAWN BY: STANTEC CONSULTING LTD DATE: NOV 18, 2013
APPROVED BY: BARRY MASON DATE: NOV 18, 2013
RECEIVED BY: DATE:


DESIGN LANDSCAPE ELEVATIONS
ELEV. AT FRONT OF HOUSE = 1034.60
ELEV. AT REAR OF HOUSE = 1035.00

I CERTIFY THAT THE FINAL LANDSCAPE GRADE WILL BE (FRONT) _____
(REAR) _____
SIGNATURE OF OWNER OR REPRESENTATIVE _____


BUILDING GRADE CERTIFICATE

Town of Olds
Issued by: No.

1. WHEN EXCAVATING IN A RIGHT OF WAY (EASEMENT), CHECK FOR UTILITIES.
2. STANDING AT THE WATER SHUTOFF AND FACING THE BUILDING, THE SANITARY SERVICE (PAINTED RED) IS ON THE LEFT SIDE OF THE WATER SERVICE; STORM SERVICE (PAINTED GREEN) IS ON THE RIGHT SIDE OF THE WATER SERVICE.
3. ALL DIMENSIONS ARE IN METRES AND DECIMALS THERE OF. THE ELEVATIONS ARE IN METRES ABOVE GEODETIC MEAN SEA LEVEL.
4. ELEVATIONS NOTED ON THE CERTIFICATE ARE WITHIN 100mm OF ACTUAL.
5. THE BUILDER MUST CONSTRUCT WITHIN 100mm OF THE DESIGN LANDSCAPE ELEVATION & ILLUSTRATED DRAINAGE PATTERNS UNLESS OTHERWISE APPROVED BY THE DEVELOPMENT OFFICER.
6. IF THE INFORMATION ON THIS CERTIFICATE HAS BEEN PREPARED BY A PRIVATE DEVELOPER OR THEIR AGENT, THE TOWN OF OLDS ACCEPTS NO RESPONSIBILITY FOR ITS ACCURACY.

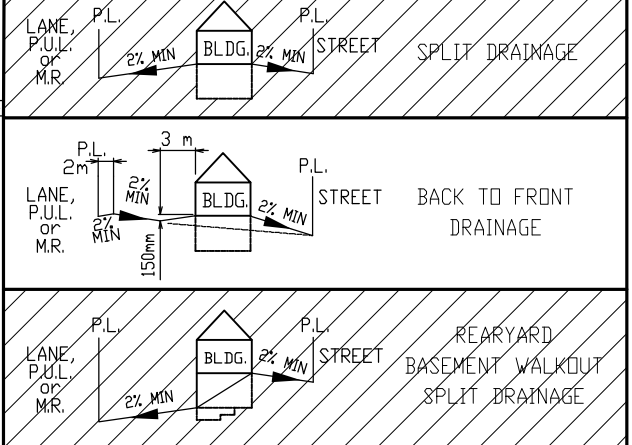

HARRISON GREEN

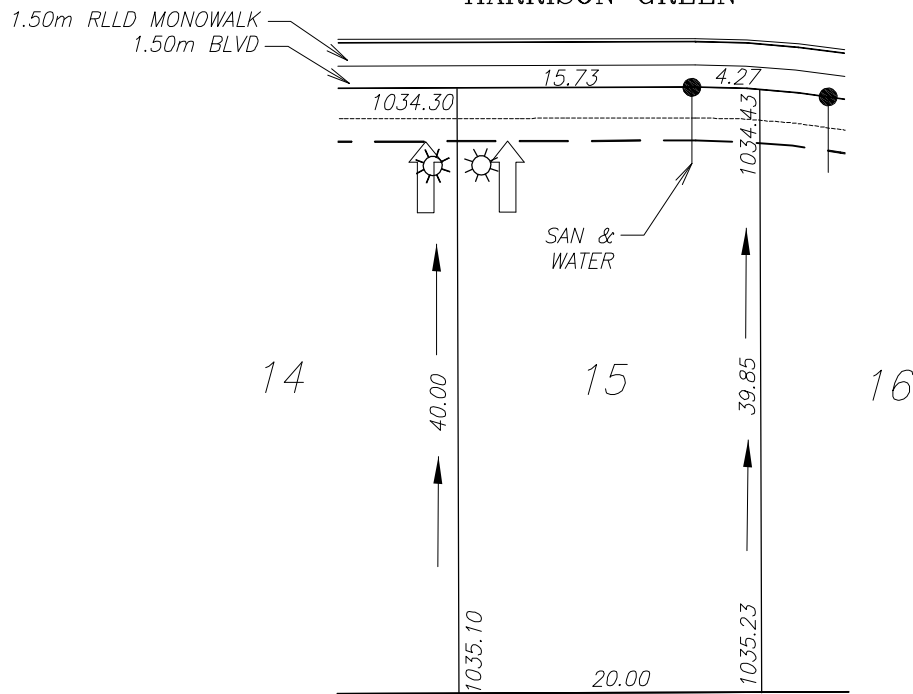

POWER SERVICE LOCATION IS 4.5m FROM SIDEYARD LOTLINE
WATER & SANITARY LOCATION IS 4.5m FROM SIDEYARD LOTLINE.

TOP OF FOOTING:
MAX. DEPTH BELOW AVERAGE SIDEWALK = 2.29
LOWEST ELEVATION = 1032.08

AS-BUILT SEWER INVERT ELEVATIONS:
SANITARY AT 4.0m INSIDE LOT = 1031.23
STORM AT 4.0m INSIDE LOT = N/A

CIVIC ADDRESS: 54 HARRISON GREEN
LOT: 15 BLOCK: 1 PLAN No.:
DEVELOPER: RICHARDSONS BROTHERS SCALE: 1:500
DRAWN BY: STANTEC CONSULTING LTD DATE: NOV 18, 2013
APPROVED BY: BARRY MASON DATE: NOV 18, 2013
RECEIVED BY: DATE:


DESIGN LANDSCAPE ELEVATIONS
ELEV. AT FRONT OF HOUSE = 1034.73
ELEV. AT REAR OF HOUSE = 1035.13

I CERTIFY THAT THE FINAL LANDSCAPE GRADE WILL BE (FRONT) _____
(REAR) _____
SIGNATURE OF OWNER OR REPRESENTATIVE _____

BUILDING GRADE CERTIFICATE


Town of Olds
Issued by: No.

1. WHEN EXCAVATING IN A RIGHT OF WAY (EASEMENT), CHECK FOR UTILITIES.
2. STANDING AT THE WATER SHUTOFF AND FACING THE BUILDING, THE SANITARY SERVICE (PAINTED RED) IS ON THE LEFT SIDE OF THE WATER SERVICE; STORM SERVICE (PAINTED GREEN) IS ON THE RIGHT SIDE OF THE WATER SERVICE.
3. ALL DIMENSIONS ARE IN METRES AND DECIMALS THERE OF. THE ELEVATIONS ARE IN METRES ABOVE GEODETIC MEAN SEA LEVEL.
4. ELEVATIONS NOTED ON THE CERTIFICATE ARE WITHIN 100mm OF ACTUAL.
5. THE BUILDER MUST CONSTRUCT WITHIN 100mm OF THE DESIGN LANDSCAPE ELEVATION & ILLUSTRATED DRAINAGE PATTERNS UNLESS OTHERWISE APPROVED BY THE DEVELOPMENT OFFICER.
6. IF THE INFORMATION ON THIS CERTIFICATE HAS BEEN PREPARED BY A PRIVATE DEVELOPER OR THEIR AGENT, THE TOWN OF OLDS ACCEPTS NO RESPONSIBILITY FOR ITS ACCURACY.

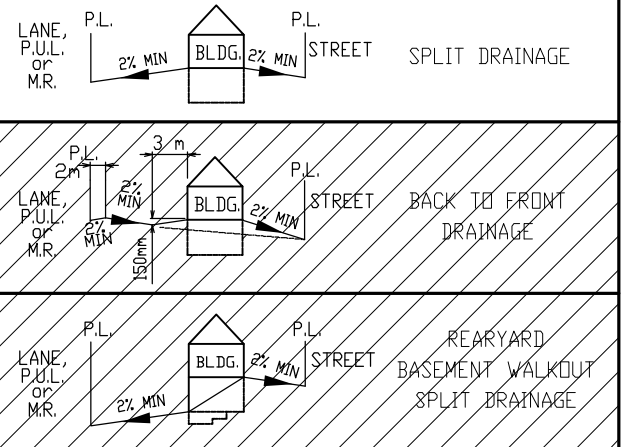

- LEGEND**
- SAN, WATER & STORM
 - ⊙ FIRE HYDRANT
 - - - GAS
 - ☀ POWER, TELEPHONE & CABLE SERVICE
 - STREET LIGHT
 - ⊠ COMMUNITY MAILBOX
 - TRANSFORMER
 - EL&P TRANSFORMER
 - SHAW PEDESTAL
 - ▲ TELEPHONE PEDESTAL
 - 3 PARTY PEDESTAL

HARRISON GREEN

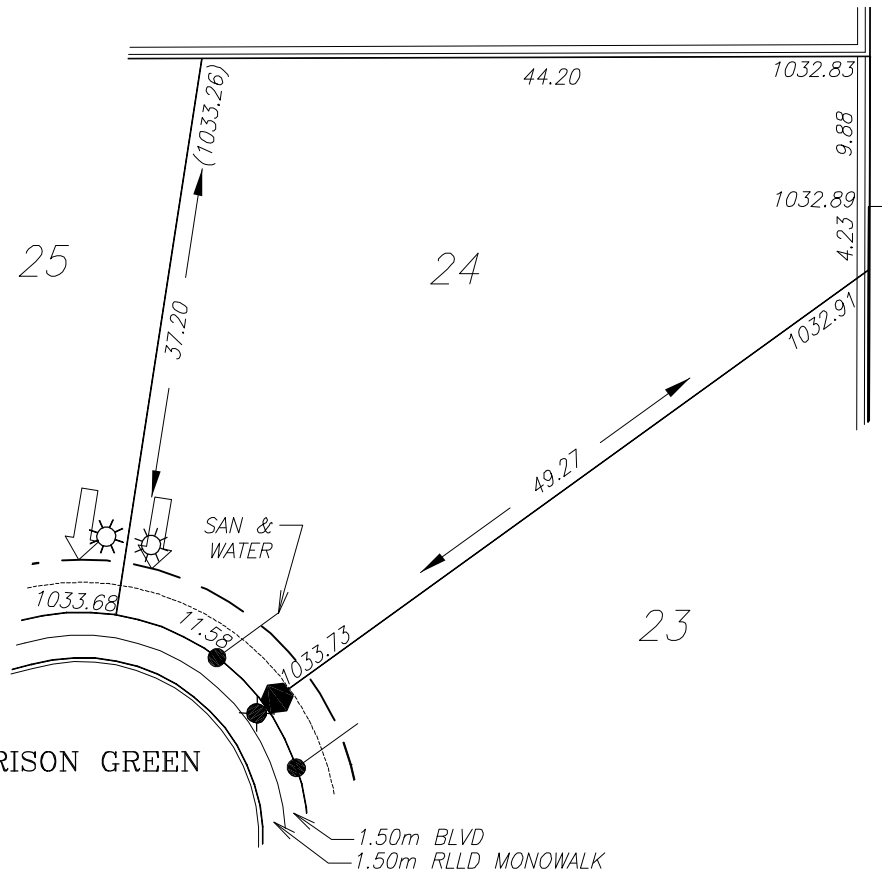

POWER SERVICE LOCATION IS 4.5m FROM SIDEYARD LOTLINE
WATER & SANITARY LOCATION IS 4.5m FROM SIDEYARD LOTLINE.

TOP OF FOOTING:
MAX. DEPTH BELOW AVERAGE SIDEWALK = 1.91
LOWEST ELEVATION = 1031.80

AS-BUILT SEWER INVERT ELEVATIONS:
SANITARY AT 4.0m INSIDE LOT = 1030.95
STORM AT 4.0m INSIDE LOT = N/A

CIVIC ADDRESS: 91 HARRISON GREEN
LOT: 24 BLOCK: 1 PLAN No.:
DEVELOPER: RICHARDSONS BROTHERS SCALE: 1:500
DRAWN BY: STANTEC CONSULTING LTD DATE: NOV 18, 2013
APPROVED BY: BARRY MASON DATE: NOV 18, 2013
RECEIVED BY: DATE:


DESIGN LANDSCAPE ELEVATIONS
ELEV. AT FRONT OF HOUSE = 1034.03
ELEV. AT REAR OF HOUSE = 1033.25

I CERTIFY THAT THE FINAL LANDSCAPE GRADE WILL BE (FRONT) (REAR)
SIGNATURE OF OWNER OR REPRESENTATIVE


BUILDING GRADE CERTIFICATE

Town of Olds
Issued by: No.

1. WHEN EXCAVATING IN A RIGHT OF WAY (EASEMENT), CHECK FOR UTILITIES.
2. STANDING AT THE WATER SHUTOFF AND FACING THE BUILDING, THE SANITARY SERVICE (PAINTED RED) IS ON THE LEFT SIDE OF THE WATER SERVICE; STORM SERVICE (PAINTED GREEN) IS ON THE RIGHT SIDE OF THE WATER SERVICE.
3. ALL DIMENSIONS ARE IN METRES AND DECIMALS THERE OF. THE ELEVATIONS ARE IN METRES ABOVE GEODETIC MEAN SEA LEVEL.
4. ELEVATIONS NOTED ON THE CERTIFICATE ARE WITHIN 100mm OF ACTUAL.
5. THE BUILDER MUST CONSTRUCT WITHIN 100mm OF THE DESIGN LANDSCAPE ELEVATION & ILLUSTRATED DRAINAGE PATTERNS UNLESS OTHERWISE APPROVED BY THE DEVELOPMENT OFFICER.
6. IF THE INFORMATION ON THIS CERTIFICATE HAS BEEN PREPARED BY A PRIVATE DEVELOPER OR THEIR AGENT, THE TOWN OF OLDS ACCEPTS NO RESPONSIBILITY FOR ITS ACCURACY.

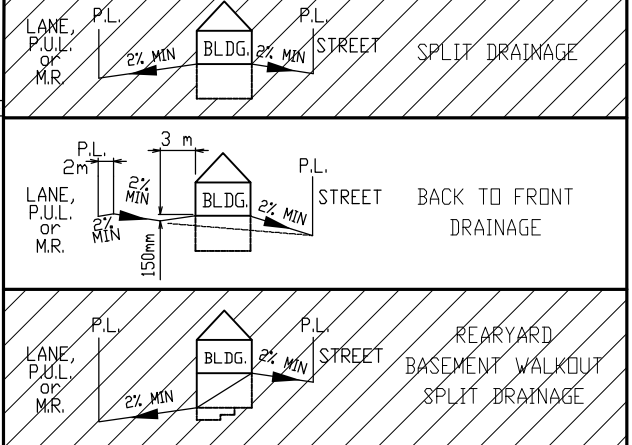

HARRISON GREEN

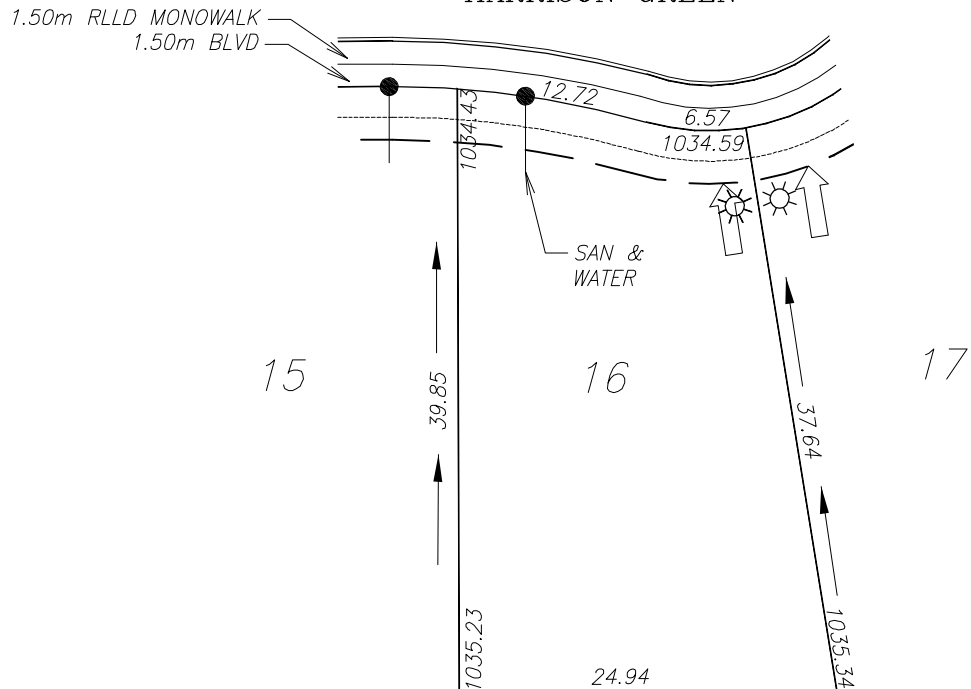

LEGEND

- SAN, WATER & STORM
- ⊙ FIRE HYDRANT
- - - GAS
- ☀ POWER, TELEPHONE & CABLE SERVICE
- ⊙ STREET LIGHT
- ⊠ COMMUNITY MAILBOX
- TRANSFORMER
- EL&P TRANSFORMER
- SHAW PEDESTAL
- ▲ TELEPHONE PEDESTAL
- 3 PARTY PEDESTAL

POWER SERVICE LOCATION IS 4.5m FROM SIDEYARD LOTLINE
WATER & SANITARY LOCATION IS 4.5m FROM SIDEYARD LOTLINE.

TOP OF FOOTING:
MAX. DEPTH BELOW AVERAGE SIDEWALK = 2.32
LOWEST ELEVATION = 1032.19

AS-BUILT SEWER INVERT ELEVATIONS:
SANITARY AT 4.0m INSIDE LOT = 1031.34
STORM AT 4.0m INSIDE LOT = N/A

CIVIC ADDRESS: 58 HARRISON GREEN
LOT: 16 BLOCK: 1 PLAN No.:
DEVELOPER: RICHARDSONS BROTHERS SCALE: 1:500
DRAWN BY: STANTEC CONSULTING LTD DATE: NOV 18, 2013
APPROVED BY: BARRY MASON DATE: NOV 18, 2013
RECEIVED BY: DATE:




DESIGN LANDSCAPE ELEVATIONS
ELEV. AT FRONT OF HOUSE = 1034.89
ELEV. AT REAR OF HOUSE = 1035.24

I CERTIFY THAT THE FINAL LANDSCAPE GRADE WILL BE (FRONT) _____
(REAR) _____
SIGNATURE OF OWNER OR REPRESENTATIVE _____

BUILDING GRADE CERTIFICATE


Town of Olds
Issued by: No.

1. WHEN EXCAVATING IN A RIGHT OF WAY (EASEMENT), CHECK FOR UTILITIES.
2. STANDING AT THE WATER SHUTOFF AND FACING THE BUILDING, THE SANITARY SERVICE (PAINTED RED) IS ON THE LEFT SIDE OF THE WATER SERVICE; STORM SERVICE (PAINTED GREEN) IS ON THE RIGHT SIDE OF THE WATER SERVICE.
3. ALL DIMENSIONS ARE IN METRES AND DECIMALS THERE OF. THE ELEVATIONS ARE IN METRES ABOVE GEODETIC MEAN SEA LEVEL.
4. ELEVATIONS NOTED ON THE CERTIFICATE ARE WITHIN 100mm OF ACTUAL.
5. THE BUILDER MUST CONSTRUCT WITHIN 100mm OF THE DESIGN LANDSCAPE ELEVATION & ILLUSTRATED DRAINAGE PATTERNS UNLESS OTHERWISE APPROVED BY THE DEVELOPMENT OFFICER.
6. IF THE INFORMATION ON THIS CERTIFICATE HAS BEEN PREPARED BY A PRIVATE DEVELOPER OR THEIR AGENT, THE TOWN OF OLDS ACCEPTS NO RESPONSIBILITY FOR ITS ACCURACY.

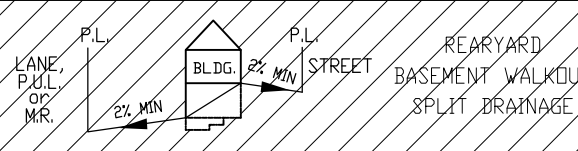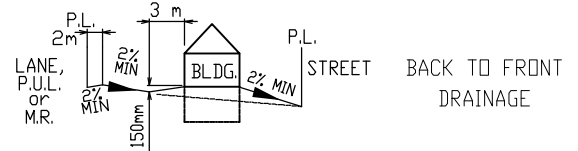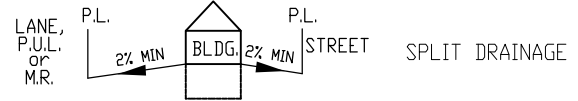

HARRISON GREEN

1.50m RLLD MONOWALK
1.50m BLVD

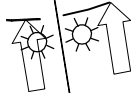

SAN & WATER


LEGEND

- SAN, WATER & STORM
- ⊙ FIRE HYDRANT
- - - GAS
- ☀ POWER, TELEPHONE & CABLE SERVICE
- STREET LIGHT
- ⊠ COMMUNITY MAILBOX
- TRANSFORMER
- EL&P TRANSFORMER
- SHAW PEDESTAL
- ▲ TELEPHONE PEDESTAL
- 3 PARTY PEDESTAL

16

17

18

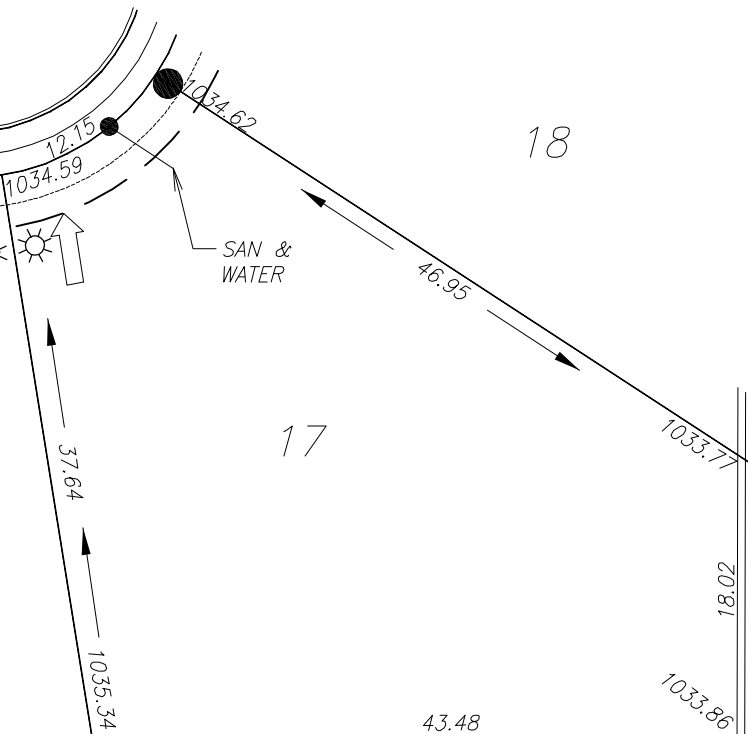

POWER SERVICE LOCATION IS 4.5m FROM SIDEYARD LOTLINE
WATER & SANITARY LOCATION IS 4.5m FROM SIDEYARD LOTLINE.

TOP OF FOOTING:
MAX. DEPTH BELOW AVERAGE SIDEWALK = 2.27
LOWEST ELEVATION = 1032.34

AS-BUILT SEWER INVERT ELEVATIONS:
SANITARY AT 4.0m INSIDE LOT = 1031.49
STORM AT 4.0m INSIDE LOT = N/A

CIVIC ADDRESS: 62 HARRISON GREEN
LOT: 17 BLOCK: 1 PLAN No.:
DEVELOPER: RICHARDSONS BROTHERS SCALE: 1:500
DRAWN BY: STANTEC CONSULTING LTD DATE: NOV 18, 2013
APPROVED BY: BARRY MASON DATE: NOV 18, 2013
RECEIVED BY: DATE:


DESIGN LANDSCAPE ELEVATIONS
ELEV. AT FRONT OF HOUSE = 1034.92
ELEV. AT REAR OF HOUSE = 1035.24

I CERTIFY THAT THE FINAL LANDSCAPE GRADE WILL BE (FRONT) _____
(REAR) _____
SIGNATURE OF OWNER OR REPRESENTATIVE _____


BUILDING GRADE CERTIFICATE

Town of Olds
Issued by: No.

1. WHEN EXCAVATING IN A RIGHT OF WAY (EASEMENT), CHECK FOR UTILITIES.
2. STANDING AT THE WATER SHUTOFF AND FACING THE BUILDING, THE SANITARY SERVICE (PAINTED RED) IS ON THE LEFT SIDE OF THE WATER SERVICE; STORM SERVICE (PAINTED GREEN) IS ON THE RIGHT SIDE OF THE WATER SERVICE.
3. ALL DIMENSIONS ARE IN METRES AND DECIMALS THERE OF. THE ELEVATIONS ARE IN METRES ABOVE GEODETIC MEAN SEA LEVEL.
4. ELEVATIONS NOTED ON THE CERTIFICATE ARE WITHIN 100mm OF ACTUAL.
5. THE BUILDER MUST CONSTRUCT WITHIN 100mm OF THE DESIGN LANDSCAPE ELEVATION & ILLUSTRATED DRAINAGE PATTERNS UNLESS OTHERWISE APPROVED BY THE DEVELOPMENT OFFICER.
6. IF THE INFORMATION ON THIS CERTIFICATE HAS BEEN PREPARED BY A PRIVATE DEVELOPER OR THEIR AGENT, THE TOWN OF OLDS ACCEPTS NO RESPONSIBILITY FOR ITS ACCURACY.

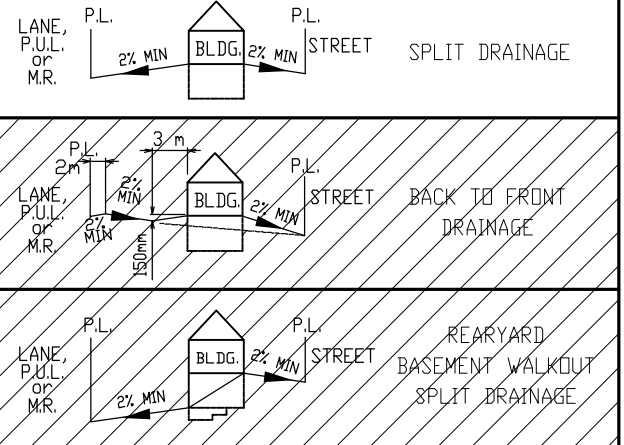

- LEGEND
- SAN, WATER & STORM
 - ⊙ FIRE HYDRANT
 - G- GAS
 - ☀ POWER, TELEPHONE & CABLE SERVICE
 - ⊗ STREET LIGHT
 - ⊠ COMMUNITY MAILBOX
 - TRANSFORMER
 - EL&P TRANSFORMER
 - SHAW PEDESTAL
 - ▲ TELEPHONE PEDESTAL
 - 3 PARTY PEDESTAL

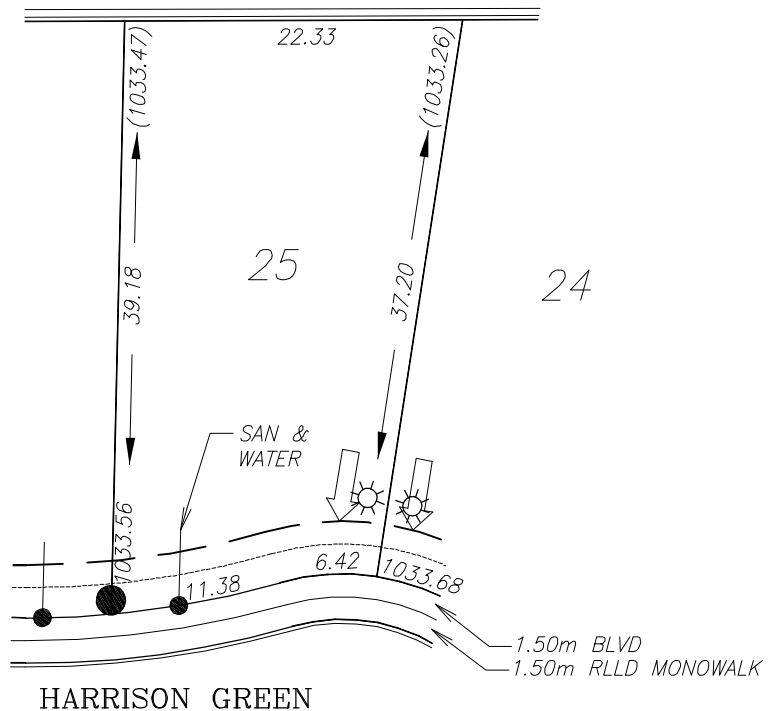

POWER SERVICE LOCATION IS 4.5m FROM SIDEYARD LOTLINE
WATER & SANITARY LOCATION IS 4.5m FROM SIDEYARD LOTLINE.

TOP OF FOOTING:
MAX. DEPTH BELOW AVERAGE SIDEWALK = 1.98
LOWEST ELEVATION = 1031.64

AS-BUILT SEWER INVERT ELEVATIONS:
SANITARY AT 4.0m INSIDE LOT = 1030.79
STORM AT 4.0m INSIDE LOT = N/A

CIVIC ADDRESS: 95 HARRISON GREEN
LOT: 25 BLOCK: 1 PLAN No.:
DEVELOPER: RICHARDSONS BROTHERS SCALE: 1:500
DRAWN BY: STANTEC CONSULTING LTD DATE: NOV 18, 2013
APPROVED BY: BARRY MASON DATE: NOV 18, 2013
RECEIVED BY: DATE:



DESIGN LANDSCAPE ELEVATIONS
ELEV. AT FRONT OF HOUSE = 1033.98
ELEV. AT REAR OF HOUSE = 1033.77

I CERTIFY THAT THE FINAL LANDSCAPE GRADE WILL BE (FRONT) _____
(REAR) _____
SIGNATURE OF OWNER OR REPRESENTATIVE _____

BUILDING GRADE CERTIFICATE

Town of Olds
Issued by: No.

1. WHEN EXCAVATING IN A RIGHT OF WAY (EASEMENT), CHECK FOR UTILITIES.
2. STANDING AT THE WATER SHUTOFF AND FACING THE BUILDING, THE SANITARY SERVICE (PAINTED RED) IS ON THE LEFT SIDE OF THE WATER SERVICE; STORM SERVICE (PAINTED GREEN) IS ON THE RIGHT SIDE OF THE WATER SERVICE.
3. ALL DIMENSIONS ARE IN METRES AND DECIMALS THERE OF. THE ELEVATIONS ARE IN METRES ABOVE GEODETIC MEAN SEA LEVEL.
4. ELEVATIONS NOTED ON THE CERTIFICATE ARE WITHIN 100mm OF ACTUAL.
5. THE BUILDER MUST CONSTRUCT WITHIN 100mm OF THE DESIGN LANDSCAPE ELEVATION & ILLUSTRATED DRAINAGE PATTERNS UNLESS OTHERWISE APPROVED BY THE DEVELOPMENT OFFICER.
6. IF THE INFORMATION ON THIS CERTIFICATE HAS BEEN PREPARED BY A PRIVATE DEVELOPER OR THEIR AGENT, THE TOWN OF OLDS ACCEPTS NO RESPONSIBILITY FOR ITS ACCURACY.

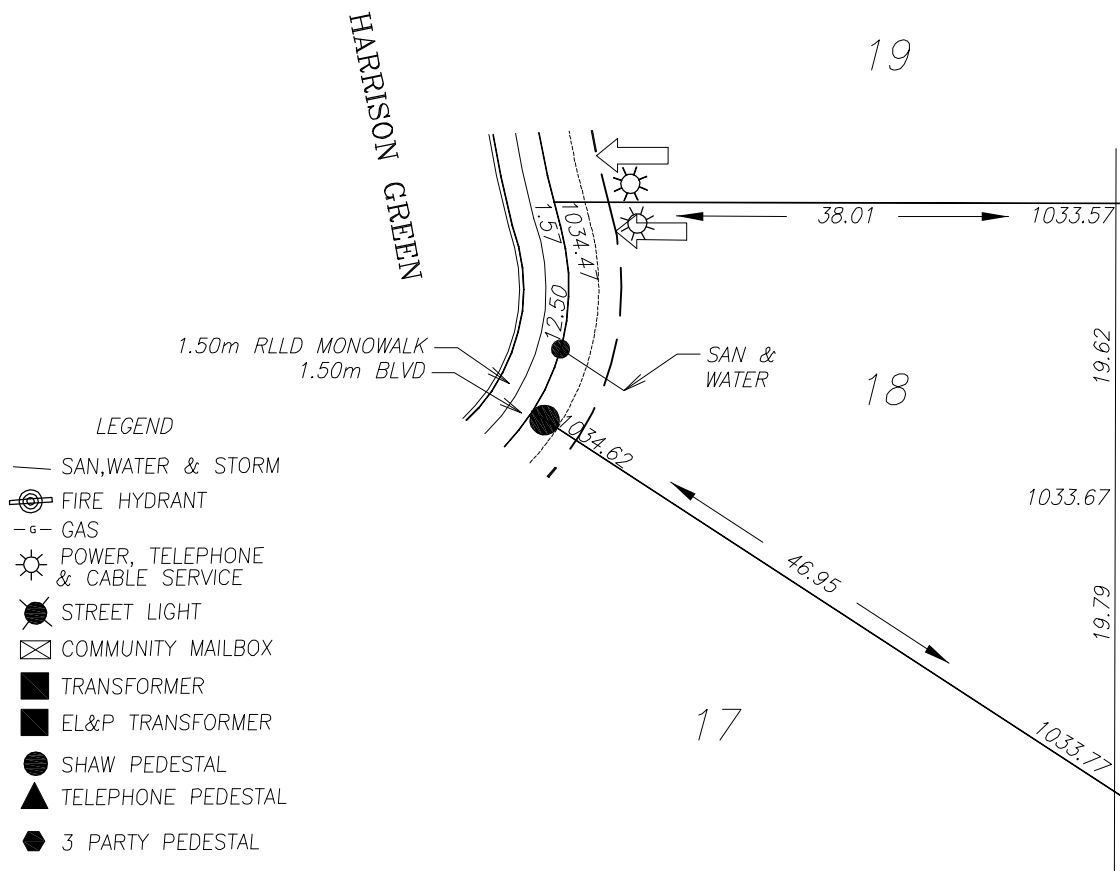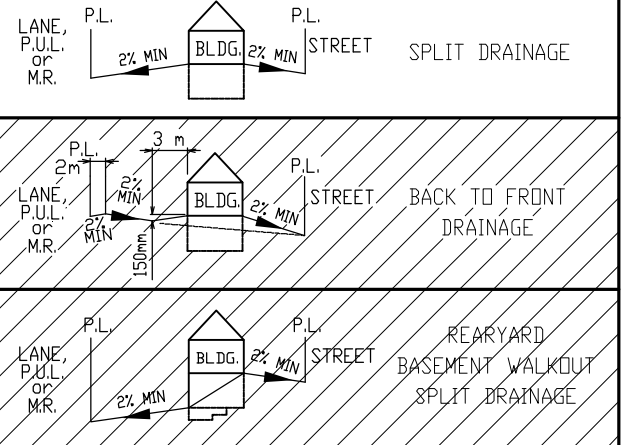

POWER SERVICE LOCATION IS 4.5m FROM SIDEYARD LOTLINE
WATER & SANITARY LOCATION IS 4.5m FROM SIDEYARD LOTLINE.

TOP OF FOOTING:
MAX. DEPTH BELOW AVERAGE SIDEWALK = 2.05
LOWEST ELEVATION = 1032.50

AS-BUILT SEWER INVERT ELEVATIONS:
SANITARY AT 4.0m INSIDE LOT = 1031.65
STORM AT 4.0m INSIDE LOT = N/A

CIVIC ADDRESS: 67 HARRISON GREEN
LOT: 18 BLOCK: 1 PLAN No.:
DEVELOPER: RICHARDSONS BROTHERS SCALE: 1:500
DRAWN BY: STANTEC CONSULTING LTD DATE: NOV 18, 2013
APPROVED BY: BARRY MASON DATE: NOV 18, 2013
RECEIVED BY: DATE:


DESIGN LANDSCAPE ELEVATIONS
ELEV. AT FRONT OF HOUSE = 1034.92
ELEV. AT REAR OF HOUSE = 1034.11

I CERTIFY THAT THE FINAL LANDSCAPE GRADE WILL BE (FRONT) _____
(REAR) _____
SIGNATURE OF OWNER OR REPRESENTATIVE _____


BUILDING GRADE CERTIFICATE

Town of Olds
Issued by: No.

1. WHEN EXCAVATING IN A RIGHT OF WAY (EASEMENT), CHECK FOR UTILITIES.
2. STANDING AT THE WATER SHUTOFF AND FACING THE BUILDING, THE SANITARY SERVICE (PAINTED RED) IS ON THE LEFT SIDE OF THE WATER SERVICE; STORM SERVICE (PAINTED GREEN) IS ON THE RIGHT SIDE OF THE WATER SERVICE.
3. ALL DIMENSIONS ARE IN METRES AND DECIMALS THERE OF. THE ELEVATIONS ARE IN METRES ABOVE GEODETIC MEAN SEA LEVEL.
4. ELEVATIONS NOTED ON THE CERTIFICATE ARE WITHIN 100mm OF ACTUAL.
5. THE BUILDER MUST CONSTRUCT WITHIN 100mm OF THE DESIGN LANDSCAPE ELEVATION & ILLUSTRATED DRAINAGE PATTERNS UNLESS OTHERWISE APPROVED BY THE DEVELOPMENT OFFICER.
6. IF THE INFORMATION ON THIS CERTIFICATE HAS BEEN PREPARED BY A PRIVATE DEVELOPER OR THEIR AGENT, THE TOWN OF OLDS ACCEPTS NO RESPONSIBILITY FOR ITS ACCURACY.

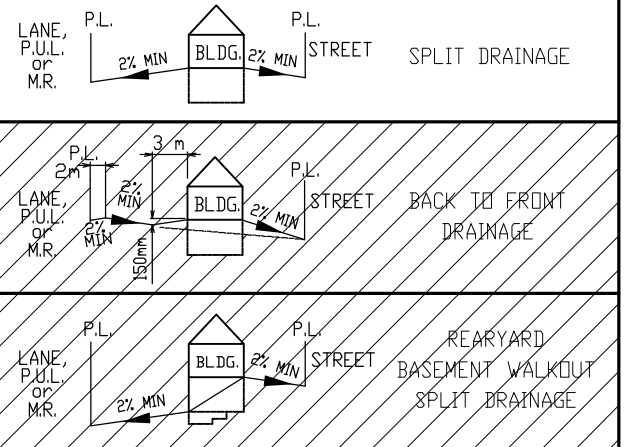

- LEGEND
- SAN, WATER & STORM
 - ⊙ FIRE HYDRANT
 - - - GAS
 - ☀ POWER, TELEPHONE & CABLE SERVICE
 - ⊙ STREET LIGHT
 - ⊠ COMMUNITY MAILBOX
 - TRANSFORMER
 - EL&P TRANSFORMER
 - SHAW PEDESTAL
 - ▲ TELEPHONE PEDESTAL
 - 3 PARTY PEDESTAL

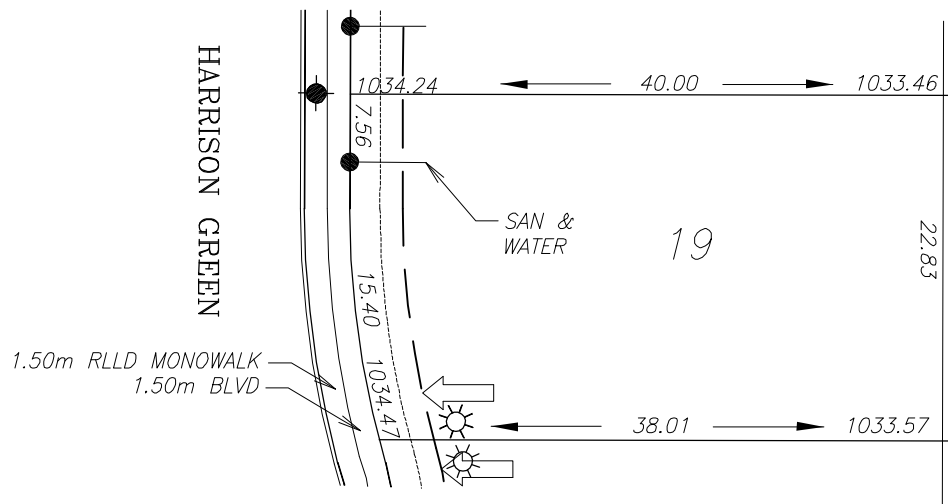

POWER SERVICE LOCATION IS 4.5m FROM SIDEYARD LOTLINE
WATER & SANITARY LOCATION IS 4.5m FROM SIDEYARD LOTLINE.

TOP OF FOOTING:
MAX. DEPTH BELOW AVERAGE SIDEWALK = 2.28
LOWEST ELEVATION = 1032.08

AS-BUILT SEWER INVERT ELEVATIONS:
SANITARY AT 4.0m INSIDE LOT = 1031.23
STORM AT 4.0m INSIDE LOT = N/A

CIVIC ADDRESS: 71 HARRISON GREEN
LOT: 19 BLOCK: 1 PLAN No.:
DEVELOPER: RICHARDSONS BROTHERS SCALE: 1:500
DRAWN BY: STANTEC CONSULTING LTD DATE: NOV 18, 2013
APPROVED BY: BARRY MASON DATE: NOV 18, 2013
RECEIVED BY: DATE:


DESIGN LANDSCAPE ELEVATIONS
ELEV. AT FRONT OF HOUSE = 1034.77
ELEV. AT REAR OF HOUSE = 1033.91

I CERTIFY THAT THE FINAL LANDSCAPE GRADE WILL BE (FRONT) (REAR)
SIGNATURE OF OWNER OR REPRESENTATIVE


BUILDING GRADE CERTIFICATE

Town of Olds
Issued by: No.

1. WHEN EXCAVATING IN A RIGHT OF WAY (EASEMENT), CHECK FOR UTILITIES.
2. STANDING AT THE WATER SHUTOFF AND FACING THE BUILDING, THE SANITARY SERVICE (PAINTED RED) IS ON THE LEFT SIDE OF THE WATER SERVICE; STORM SERVICE (PAINTED GREEN) IS ON THE RIGHT SIDE OF THE WATER SERVICE.
3. ALL DIMENSIONS ARE IN METRES AND DECIMALS THERE OF. THE ELEVATIONS ARE IN METRES ABOVE GEODETIC MEAN SEA LEVEL.
4. ELEVATIONS NOTED ON THE CERTIFICATE ARE WITHIN 100mm OF ACTUAL.
5. THE BUILDER MUST CONSTRUCT WITHIN 100mm OF THE DESIGN LANDSCAPE ELEVATION & ILLUSTRATED DRAINAGE PATTERNS UNLESS OTHERWISE APPROVED BY THE DEVELOPMENT OFFICER.
6. IF THE INFORMATION ON THIS CERTIFICATE HAS BEEN PREPARED BY A PRIVATE DEVELOPER OR THEIR AGENT, THE TOWN OF OLDS ACCEPTS NO RESPONSIBILITY FOR ITS ACCURACY.

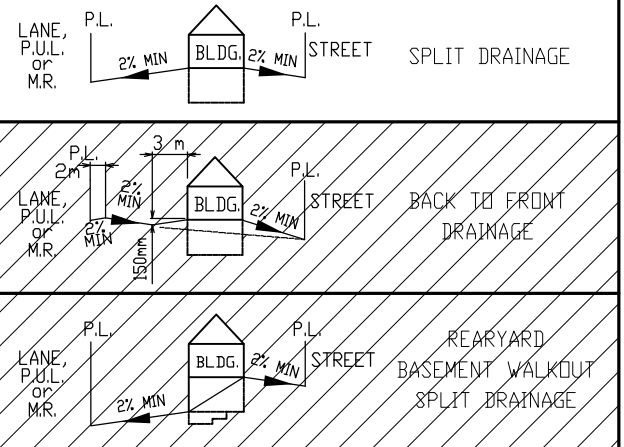

- LEGEND**
- SAN, WATER & STORM
 - ⊙ FIRE HYDRANT
 - G- GAS
 - ☀ POWER, TELEPHONE & CABLE SERVICE
 - ⊙ STREET LIGHT
 - ⊠ COMMUNITY MAILBOX
 - TRANSFORMER
 - EL&P TRANSFORMER
 - SHAW PEDESTAL
 - ▲ TELEPHONE PEDESTAL
 - 3 PARTY PEDESTAL

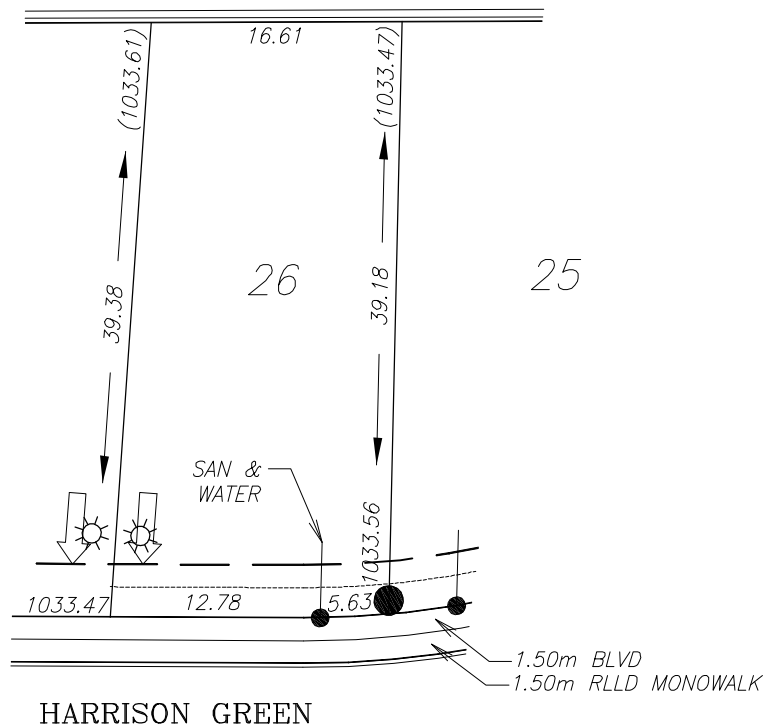

POWER SERVICE LOCATION IS 4.5m FROM SIDEYARD LOTLINE
WATER & SANITARY LOCATION IS 4.5m FROM SIDEYARD LOTLINE.

TOP OF FOOTING:
MAX. DEPTH BELOW AVERAGE SIDEWALK = 1.99
LOWEST ELEVATION = 1031.53

AS-BUILT SEWER INVERT ELEVATIONS:
SANITARY AT 4.0m INSIDE LOT = 1030.68
STORM AT 4.0m INSIDE LOT = N/A

CIVIC ADDRESS: 99 HARRISON GREEN
LOT: 26 BLOCK: 1 PLAN No.:
DEVELOPER: RICHARDSONS BROTHERS SCALE: 1:500
DRAWN BY: STANTEC CONSULTING LTD DATE: NOV 18, 2013
APPROVED BY: BARRY MASON DATE: NOV 18, 2013
RECEIVED BY: DATE:


DESIGN LANDSCAPE ELEVATIONS
ELEV. AT FRONT OF HOUSE = 1033.86
ELEV. AT REAR OF HOUSE = 1033.91

I CERTIFY THAT THE FINAL LANDSCAPE GRADE WILL BE (FRONT) (REAR)
SIGNATURE OF OWNER OR REPRESENTATIVE

BUILDING GRADE CERTIFICATE

Town of Olds
Issued by: No.

1. WHEN EXCAVATING IN A RIGHT OF WAY (EASEMENT), CHECK FOR UTILITIES.
2. STANDING AT THE WATER SHUTOFF AND FACING THE BUILDING, THE SANITARY SERVICE (PAINTED RED) IS ON THE LEFT SIDE OF THE WATER SERVICE; STORM SERVICE (PAINTED GREEN) IS ON THE RIGHT SIDE OF THE WATER SERVICE.
3. ALL DIMENSIONS ARE IN METRES AND DECIMALS THERE OF. THE ELEVATIONS ARE IN METRES ABOVE GEODETIC MEAN SEA LEVEL.
4. ELEVATIONS NOTED ON THE CERTIFICATE ARE WITHIN 100mm OF ACTUAL.
5. THE BUILDER MUST CONSTRUCT WITHIN 100mm OF THE DESIGN LANDSCAPE ELEVATION & ILLUSTRATED DRAINAGE PATTERNS UNLESS OTHERWISE APPROVED BY THE DEVELOPMENT OFFICER.
6. IF THE INFORMATION ON THIS CERTIFICATE HAS BEEN PREPARED BY A PRIVATE DEVELOPER OR THEIR AGENT, THE TOWN OF OLDS ACCEPTS NO RESPONSIBILITY FOR ITS ACCURACY.

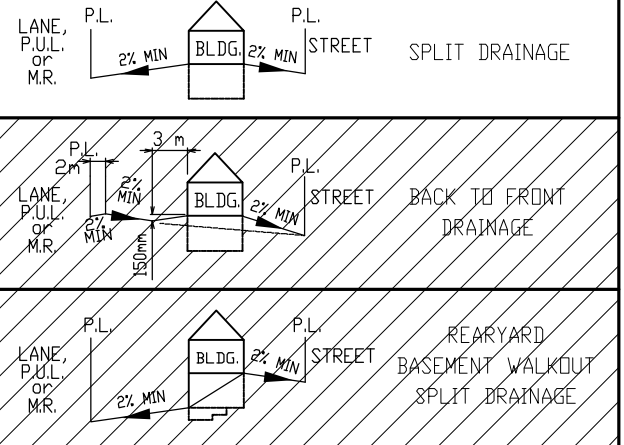


21

HARRISON GREEN

LEGEND

- SAN, WATER & STORM
- ⊙ FIRE HYDRANT
- - - GAS
- ☀ POWER, TELEPHONE & CABLE SERVICE
- ⊙ STREET LIGHT
- ⊠ COMMUNITY MAILBOX
- TRANSFORMER
- EL&P TRANSFORMER
- SHAW PEDESTAL
- ▲ TELEPHONE PEDESTAL
- 3 PARTY PEDESTAL

1.50m RLLD MONOWALK
1.50m BLVD

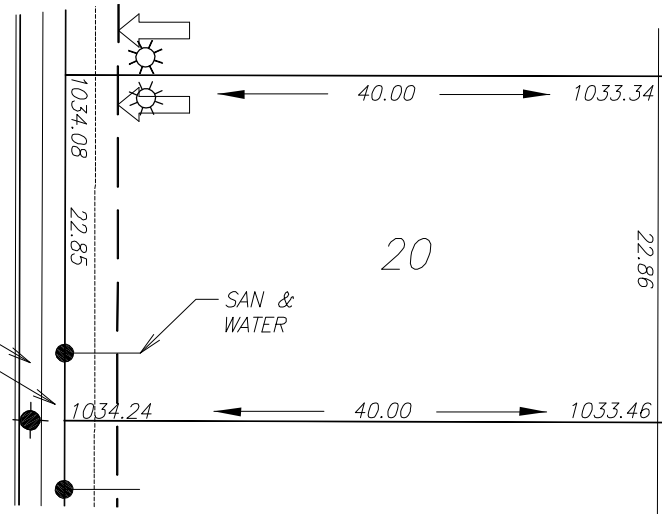

19

POWER SERVICE LOCATION IS 4.5m FROM SIDEYARD LOTLINE
WATER & SANITARY LOCATION IS 4.5m FROM SIDEYARD LOTLINE.

TOP OF FOOTING:
MAX. DEPTH BELOW AVERAGE SIDEWALK = 2.18
LOWEST ELEVATION = 1031.98

AS-BUILT SEWER INVERT ELEVATIONS:
SANITARY AT 4.0m INSIDE LOT = 1031.13
STORM AT 4.0m INSIDE LOT = N/A

CIVIC ADDRESS: 75 HARRISON GREEN
LOT: 20 BLOCK: 1 PLAN No.:
DEVELOPER: RICHARDSONS BROTHERS SCALE: 1:500
DRAWN BY: STANTEC CONSULTING LTD DATE: NOV 18, 2013
APPROVED BY: BARRY MASON DATE: NOV 18, 2013
RECEIVED BY: DATE:



DESIGN LANDSCAPE ELEVATIONS
ELEV. AT FRONT OF HOUSE = 1034.54
ELEV. AT REAR OF HOUSE = 1033.80

I CERTIFY THAT THE FINAL LANDSCAPE GRADE WILL BE (FRONT) _____
(REAR) _____
SIGNATURE OF OWNER OR REPRESENTATIVE _____

BUILDING GRADE CERTIFICATE

Town of Olds
Issued by: No.

1. WHEN EXCAVATING IN A RIGHT OF WAY (EASEMENT), CHECK FOR UTILITIES.
2. STANDING AT THE WATER SHUTOFF AND FACING THE BUILDING, THE SANITARY SERVICE (PAINTED RED) IS ON THE LEFT SIDE OF THE WATER SERVICE; STORM SERVICE (PAINTED GREEN) IS ON THE RIGHT SIDE OF THE WATER SERVICE.
3. ALL DIMENSIONS ARE IN METRES AND DECIMALS THERE OF. THE ELEVATIONS ARE IN METRES ABOVE GEODETIC MEAN SEA LEVEL.
4. ELEVATIONS NOTED ON THE CERTIFICATE ARE WITHIN 100mm OF ACTUAL.
5. THE BUILDER MUST CONSTRUCT WITHIN 100mm OF THE DESIGN LANDSCAPE ELEVATION & ILLUSTRATED DRAINAGE PATTERNS UNLESS OTHERWISE APPROVED BY THE DEVELOPMENT OFFICER.
6. IF THE INFORMATION ON THIS CERTIFICATE HAS BEEN PREPARED BY A PRIVATE DEVELOPER OR THEIR AGENT, THE TOWN OF OLDS ACCEPTS NO RESPONSIBILITY FOR ITS ACCURACY.

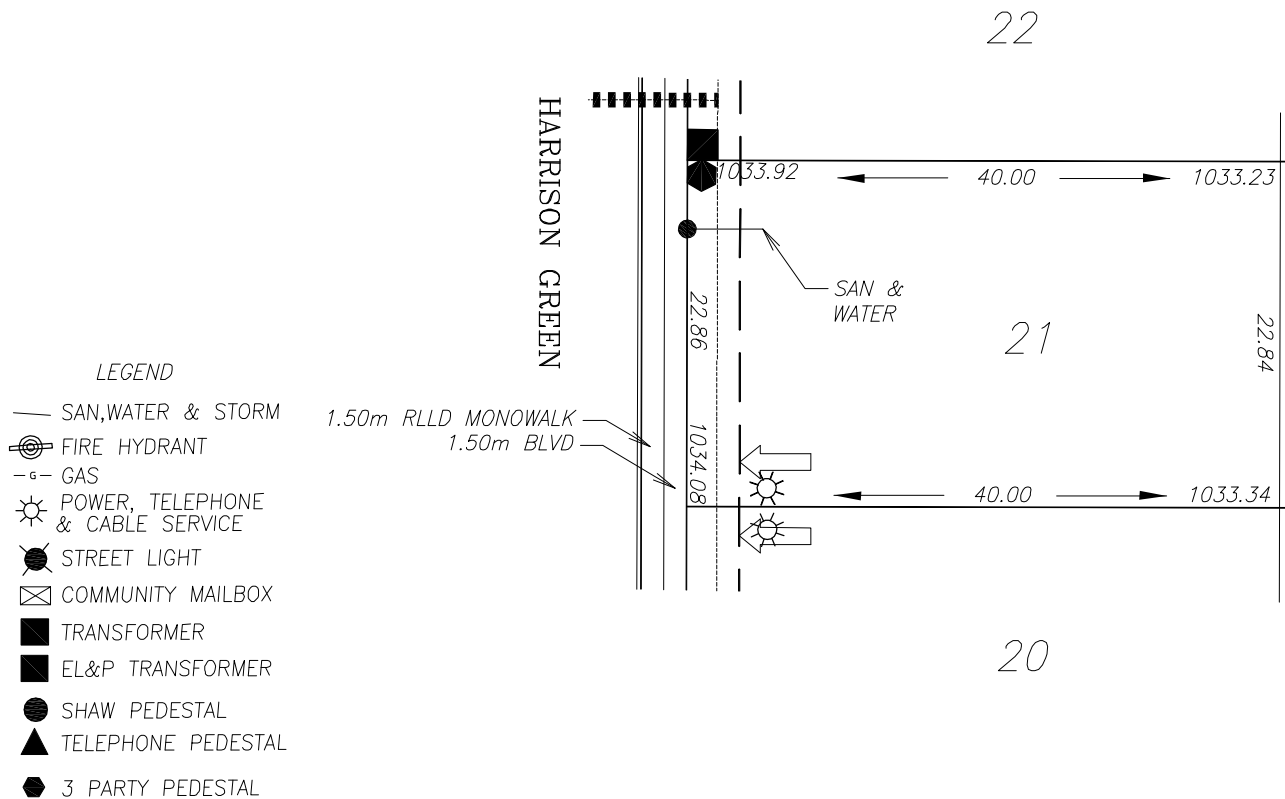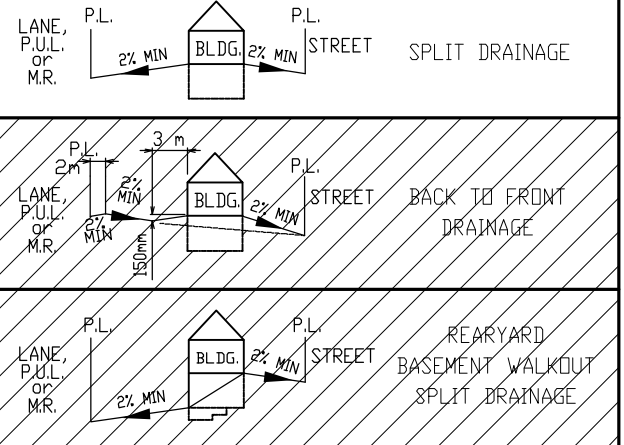

POWER SERVICE LOCATION IS 4.5m FROM SIDEYARD LOTLINE
WATER & SANITARY LOCATION IS 4.5m FROM SIDEYARD LOTLINE.

TOP OF FOOTING:
MAX. DEPTH BELOW AVERAGE SIDEWALK = 2.11
LOWEST ELEVATION = 1031.89

AS-BUILT SEWER INVERT ELEVATIONS:
SANITARY AT 4.0m INSIDE LOT = 1031.04
STORM AT 4.0m INSIDE LOT = N/A

CIVIC ADDRESS: 79 HARRISON GREEN
LOT: 21 BLOCK: 1 PLAN No.:
DEVELOPER: RICHARDSONS BROTHERS SCALE: 1:500
DRAWN BY: STANTEC CONSULTING LTD DATE: NOV 18, 2013
APPROVED BY: BARRY MASON DATE: NOV 18, 2013
RECEIVED BY: DATE:



DESIGN LANDSCAPE ELEVATIONS
ELEV. AT FRONT OF HOUSE = 1034.38
ELEV. AT REAR OF HOUSE = 1033.68

I CERTIFY THAT THE FINAL LANDSCAPE GRADE WILL BE (FRONT) (REAR)
SIGNATURE OF OWNER OR REPRESENTATIVE

BUILDING GRADE CERTIFICATE

Town of Olds
Issued by: No.

1. WHEN EXCAVATING IN A RIGHT OF WAY (EASEMENT), CHECK FOR UTILITIES.
2. STANDING AT THE WATER SHUTOFF AND FACING THE BUILDING, THE SANITARY SERVICE (PAINTED RED) IS ON THE LEFT SIDE OF THE WATER SERVICE; STORM SERVICE (PAINTED GREEN) IS ON THE RIGHT SIDE OF THE WATER SERVICE.
3. ALL DIMENSIONS ARE IN METRES AND DECIMALS THERE OF. THE ELEVATIONS ARE IN METRES ABOVE GEODETIC MEAN SEA LEVEL.
4. ELEVATIONS NOTED ON THE CERTIFICATE ARE WITHIN 100mm OF ACTUAL.
5. THE BUILDER MUST CONSTRUCT WITHIN 100mm OF THE DESIGN LANDSCAPE ELEVATION & ILLUSTRATED DRAINAGE PATTERNS UNLESS OTHERWISE APPROVED BY THE DEVELOPMENT OFFICER.
6. IF THE INFORMATION ON THIS CERTIFICATE HAS BEEN PREPARED BY A PRIVATE DEVELOPER OR THEIR AGENT, THE TOWN OF OLDS ACCEPTS NO RESPONSIBILITY FOR ITS ACCURACY.

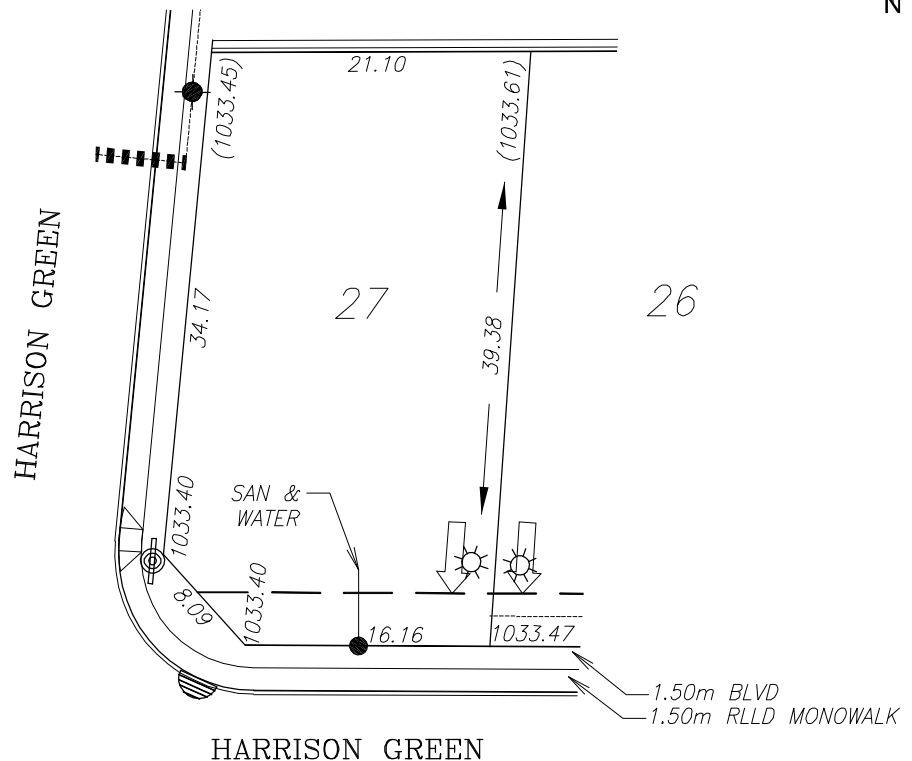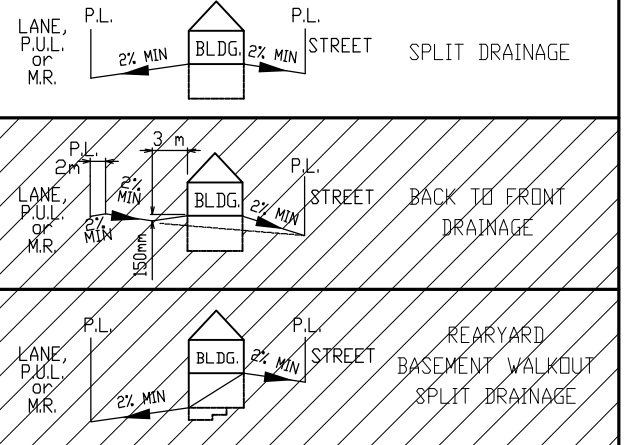

LEGEND

- SAN, WATER & STORM
- ⊙ FIRE HYDRANT
- G- GAS
- ☀ POWER, TELEPHONE & CABLE SERVICE
- ⊙ STREET LIGHT
- ⊠ COMMUNITY MAILBOX
- TRANSFORMER
- EL&P TRANSFORMER
- SHAW PEDESTAL
- ▲ TELEPHONE PEDESTAL
- 3 PARTY PEDESTAL

POWER SERVICE LOCATION IS 4.5m FROM SIDEYARD LOTLINE
WATER & SANITARY LOCATION IS 4.5m FROM SIDEYARD LOTLINE.

TOP OF FOOTING:
MAX. DEPTH BELOW AVERAGE SIDEWALK = 1.96
LOWEST ELEVATION = 1031.46

AS-BUILT SEWER INVERT ELEVATIONS:
SANITARY AT 4.0m INSIDE LOT = 1030.61
STORM AT 4.0m INSIDE LOT = N/A

CIVIC ADDRESS: 103 HARRISON GREEN
LOT: 27 BLOCK: 1 PLAN No.:
DEVELOPER: RICHARDSONS BROTHERS SCALE: 1:500
DRAWN BY: STANTEC CONSULTING LTD DATE: NOV 18, 2013
APPROVED BY: BARRY MASON DATE: NOV 18, 2013
RECEIVED BY: DATE:



DESIGN LANDSCAPE ELEVATIONS
ELEV. AT FRONT OF HOUSE = 1033.77
ELEV. AT REAR OF HOUSE = 1033.91

I CERTIFY THAT THE FINAL LANDSCAPE GRADE WILL BE (FRONT) _____
(REAR) _____
SIGNATURE OF OWNER OR REPRESENTATIVE _____

BUILDING GRADE CERTIFICATE

Town of Olds
Issued by: No.

1. WHEN EXCAVATING IN A RIGHT OF WAY (EASEMENT), CHECK FOR UTILITIES.
2. STANDING AT THE WATER SHUTOFF AND FACING THE BUILDING, THE SANITARY SERVICE (PAINTED RED) IS ON THE LEFT SIDE OF THE WATER SERVICE; STORM SERVICE (PAINTED GREEN) IS ON THE RIGHT SIDE OF THE WATER SERVICE.
3. ALL DIMENSIONS ARE IN METRES AND DECIMALS THERE OF. THE ELEVATIONS ARE IN METRES ABOVE GEODETIC MEAN SEA LEVEL.
4. ELEVATIONS NOTED ON THE CERTIFICATE ARE WITHIN 100mm OF ACTUAL.
5. THE BUILDER MUST CONSTRUCT WITHIN 100mm OF THE DESIGN LANDSCAPE ELEVATION & ILLUSTRATED DRAINAGE PATTERNS UNLESS OTHERWISE APPROVED BY THE DEVELOPMENT OFFICER.
6. IF THE INFORMATION ON THIS CERTIFICATE HAS BEEN PREPARED BY A PRIVATE DEVELOPER OR THEIR AGENT, THE TOWN OF OLDS ACCEPTS NO RESPONSIBILITY FOR ITS ACCURACY.

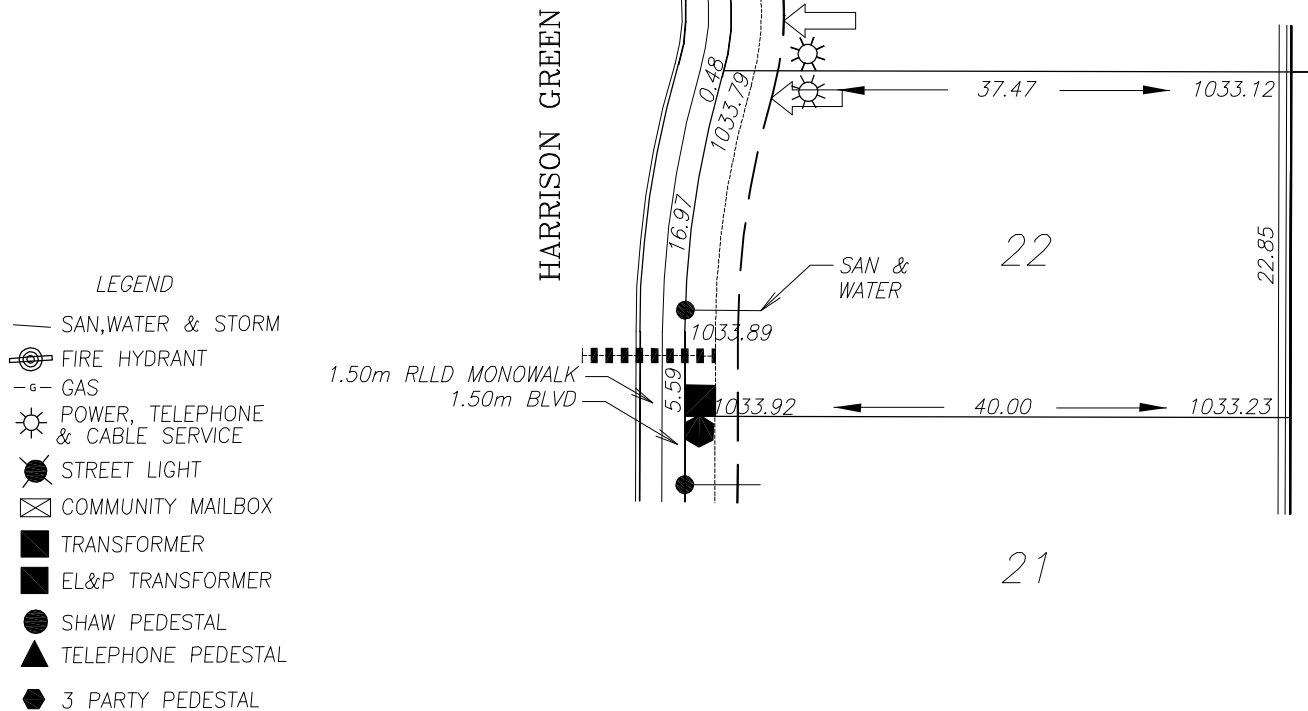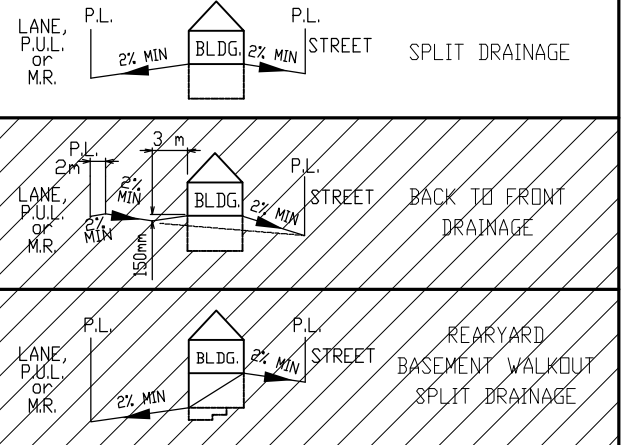

POWER SERVICE LOCATION IS 4.5m FROM SIDEYARD LOTLINE
WATER & SANITARY LOCATION IS 4.5m FROM SIDEYARD LOTLINE.

TOP OF FOOTING:
MAX. DEPTH BELOW AVERAGE SIDEWALK = 2.06
LOWEST ELEVATION = 1031.81

AS-BUILT SEWER INVERT ELEVATIONS:
SANITARY AT 4.0m INSIDE LOT = 1030.96
STORM AT 4.0m INSIDE LOT = N/A

CIVIC ADDRESS: 83 HARRISON GREEN
LOT: 22 BLOCK: 1 PLAN No.:
DEVELOPER: RICHARDSONS BROTHERS SCALE: 1:500
DRAWN BY: STANTEC CONSULTING LTD DATE: NOV 18, 2013
APPROVED BY: BARRY MASON DATE: NOV 18, 2013
RECEIVED BY: DATE:


DESIGN LANDSCAPE ELEVATIONS
ELEV. AT FRONT OF HOUSE = 1034.22
ELEV. AT REAR OF HOUSE = 1033.57

I CERTIFY THAT THE FINAL LANDSCAPE GRADE WILL BE (FRONT) (REAR)
SIGNATURE OF OWNER OR REPRESENTATIVE

BUILDING GRADE CERTIFICATE

Town of Olds
Issued by: No.

1. WHEN EXCAVATING IN A RIGHT OF WAY (EASEMENT), CHECK FOR UTILITIES.
2. STANDING AT THE WATER SHUTOFF AND FACING THE BUILDING, THE SANITARY SERVICE (PAINTED RED) IS ON THE LEFT SIDE OF THE WATER SERVICE; STORM SERVICE (PAINTED GREEN) IS ON THE RIGHT SIDE OF THE WATER SERVICE.
3. ALL DIMENSIONS ARE IN METRES AND DECIMALS THERE OF. THE ELEVATIONS ARE IN METRES ABOVE GEODETIC MEAN SEA LEVEL.
4. ELEVATIONS NOTED ON THE CERTIFICATE ARE WITHIN 100mm OF ACTUAL.
5. THE BUILDER MUST CONSTRUCT WITHIN 100mm OF THE DESIGN LANDSCAPE ELEVATION & ILLUSTRATED DRAINAGE PATTERNS UNLESS OTHERWISE APPROVED BY THE DEVELOPMENT OFFICER.
6. IF THE INFORMATION ON THIS CERTIFICATE HAS BEEN PREPARED BY A PRIVATE DEVELOPER OR THEIR AGENT, THE TOWN OF OLDS ACCEPTS NO RESPONSIBILITY FOR ITS ACCURACY.

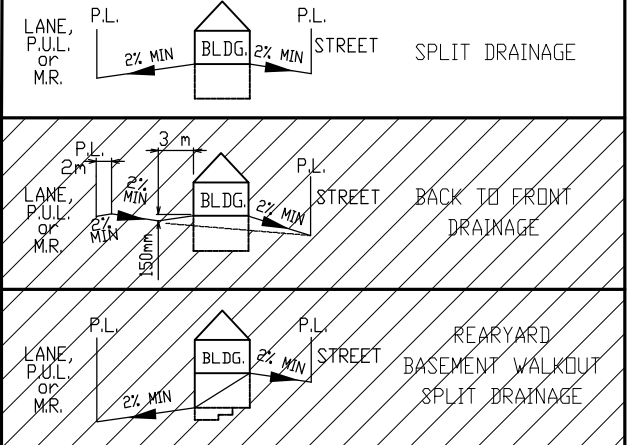


- LEGEND**
- SAN, WATER & STORM
 - ⊙ FIRE HYDRANT
 - - - GAS
 - ☀ POWER, TELEPHONE & CABLE SERVICE
 - STREET LIGHT
 - ⊠ COMMUNITY MAILBOX
 - TRANSFORMER
 - EL&P TRANSFORMER
 - SHAW PEDESTAL
 - ▲ TELEPHONE PEDESTAL
 - 3 PARTY PEDESTAL

HARRISON GREEN

1.50m RLLD MONOWALK
1.50m BLVD

SAN & WATER

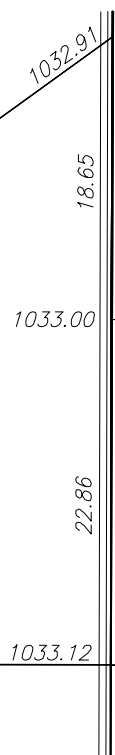

POWER SERVICE LOCATION IS 4.5m FROM SIDEYARD LOTLINE
WATER & SANITARY LOCATION IS 4.5m FROM SIDEYARD LOTLINE.

TOP OF FOOTING:
MAX. DEPTH BELOW AVERAGE SIDEWALK = 2.50
LOWEST ELEVATION = 1031.26

AS-BUILT SEWER INVERT ELEVATIONS:
SANITARY AT 4.0m INSIDE LOT = 1030.96
STORM AT 4.0m INSIDE LOT = N/A

CIVIC ADDRESS: 87 HARRISON GREEN
LOT: 23 BLOCK: 1 PLAN No.:
DEVELOPER: RICHARDSONS BROTHERS SCALE: 1:500
DRAWN BY: STANTEC CONSULTING LTD DATE: NOV 18, 2013
APPROVED BY: BARRY MASON DATE: NOV 18, 2013
RECEIVED BY: DATE:

DESIGN LANDSCAPE ELEVATIONS
ELEV. AT FRONT OF HOUSE = 1034.09
ELEV. AT REAR OF HOUSE = 1033.46

I CERTIFY THAT THE FINAL LANDSCAPE GRADE WILL BE (FRONT) _____
(REAR) _____
SIGNATURE OF OWNER OR REPRESENTATIVE _____